

SURVEY & REMONUMENTATION

MAY 31 2000

1996 Remonumentation Program
LAND CORNER RECORDATION CERTIFICATE
 Filing Requirement of Act 74, Mich. P.A. 1970

MASTER LIBER 3434 PAGE 296

SECTION

For corners in

_____ Genesee _____	Located In:	Corner Code #
(county)		
1. Public Land Survey	T 8N R 8E	E-5
	T _____ R _____	_____
	T _____ R _____	_____
	T _____ R _____	_____
2. Property Controlling	S _____ T _____ R _____	_____
in Section	S _____ T _____ R _____	_____
3. Miscellaneous	S _____ T _____ R _____	_____
Property in Sec.	S _____ T _____ R _____	_____

07/12/96 REGISTERED

82433

RECORDED

DEC 23 2 07 PM '96

REGISTERED

9.00

filed

new

Register of Deeds Stamp & File Number

4. Lot No. _____, Recorded Plat _____

5. Private Claims _____

I, James E. Kovas, in a field survey on September 25, 1996, do hereby certify that under requirements of P.A. 74, Michigan P.A. of 1970, the corner points mentioned in lines 1 and 2 above were in conformance with regulations and rules therefore as required in the current manual of survey instructions of the United States Department of the Interior, Bureau of Land Management or by a decree of a Court of Law and/or that the corner points mentioned in lines 3, 4 and 5 above were in conformance with the rules of the Michigan Board of Land Surveyors or by a Decree of a Court of Law; established, re-established, monumented, re-monumented, recovered, found as expressed below:

A	B	C	D	E	F	G	H	I	J	K	L	M
2	6	5	4	3	2	1						
3												
4	7	8	9	10	11	12						
5												
6	18	17	16	15	14	13						
7												
8	19	20	21	22	23	24						
9												
10	30	29	28	27	26	25						
11												
12	31	32	33	34	35	36						
13												

NOTE: Not more than 4 corners, all in the same town and range, may be recorded on this certificate.

A. Description of original monument and accessories and/or subsequent restoration:

- E-5 1821 - G.L.O. Set Corner WIT: S20E 16 Lks. Pine; N60°W 16 Lks. Ash
 - 1965 - Genesee Co. Road Comm., Section Notes, Pipe WIT: NNW 63.9' 12" Willow; ENE 58.8' 24" Willow; SSE 97.3' 8" Sugar Maple; SW 46.4' N.Tree 3" Maple Clump; WSW 61.4' 3" Elm.
 - 1978 - Rowe Eng., Section Notes, Pipe WIT: NNW 63.9' 12" Willow; ENE 58.8' 24" Willow; SSE 97.3' 8" Sugar Maple; SW 46.4' N.Tree 3" Maple Clump; WSW 61.4' 3" Elm.
 - 1987 - Rowe Eng., Survey, 2" Iron Pipe WIT: N15°W 20.20' NNE Face 14" Maple; South 7.47' E.Face 10" Maple; S70°E 63.10' S.Face 12" Sycamore; N35°E 34.77' W.Face Twin 10" Maple; S10°E 31.24' E.Face 14" Maple.
- Distances: E-5 to E-4 = 2640.00' (GLO); 2660.98' (Wade-Trim) E-5 to F-5 = 2629.44' (GLO); 2617.24' (Wade-Trim)
 E-5 to D-5 = 2645.94' (GLO); 2643.59' (Wade-Trim)

B. Description of corner evidence found and/or method applied in restoring or reestablishing corner:


- E-5 Found 2" Iron Pipe
- WIT: N15°W 20.21' Fnd Nail/Tag#11192 NNE Face 14" Maple
- South 7.56' Fnd Nail/Tag#11192 E.Face 10" Maple
- N35°E 34.70' Fnd Nail/Tag#11192 W.Face Twin 10" Maple
- S10°E 31.23' Fnd Nail/Tag#11192 E.Face 14" Maple

Ratified by Peer Group in accordance with P.A. 345, 1990
 Co. Rep. Carl Kahn
 Date 10-30-96

The monument found was ratified by the Peer Review Committee on October 30, 1996, as the accepted corner.

C. Description of monument for corner and accessories established to perpetuate locating the position of the corner:

- E-5 Set 2" X 30" Iron Pipe with Brass Genesee County Remonumentation Cap over the 2" Iron Pipe.
- WIT: N76°E 23.04' Set 60d Nail/Genesee Co. Tag SE Face 24" Maple
- S26°E 20.73' Set 60d Nail/Genesee Co. Tag NE Face 18" Maple
- S11°W 7.35' Set 60d Nail/Genesee Co. Tag E.Face 12" Maple
- N78°W 22.57' Set 60d Nail/Genesee Co. Tag N.Face 12" Maple
- N27°W 20.19' Set 60d Nail/Genesee Co. Tag NE Face 18" Maple
- South 31.24' Fnd Nail/Rowe Flasher NE Face 20" Maple
- S70°E 90' to W.Edge of mowed baseball diamond
- N70°W 160' to centerline intersection of Park Drive and North intersection of dirt pull off

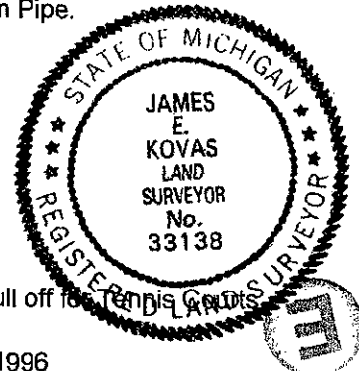

Signed by James E. Kovas Date December 20, 1996

Surveyor's Michigan License No. 33138