

REMONUMENTATION

MAY 20 1937

COMMISSION

1996 Remonumentation Program
LAND CORNER RECORDATION CERTIFICATE
Filing Requirement of Act 74, Mich. P.A. 1970

MASTER LIBER 3434 PAGE 297

For corners in
Genesee

(county)	Located In:	Corner Code #
1. Public Land Survey	T 8N R 8E	F-5
	T R	
	T R	
	T R	
2. Property Controlling in Section	S T R	
	S T R	
3. Miscellaneous Property in Sec.	S T R	
	S T R	

Dec 23 2 07 PM '96
RECORDED
82438
9.00 file
Register of Deeds Stamp & File Number

4. Lot No. _____, Recorded Plat _____

5. Private Claims _____

I, James E. Kovas, in a field survey on November 12, 1996, do hereby certify that under requirements of P.A. 74, Michigan P.A. of 1970, the corner points mentioned in lines 1 and 2 above were in conformance with regulations and rules therefore as required in the current manual of survey instructions of the United States Department of the Interior, Bureau of Land Management or by a decree of a Court of Law and/or that the corner points mentioned in lines 3, 4 and 5 above were in conformance with the rules of the Michigan Board of Land Surveyors or by a Decree of a Court of Law; established, re-established, monumented, re-monumented, recovered, found as expressed below:

	A	B	C	D	E	F	G	H	I	J	K	L	I
2	6	5	4	3	2	1							
3													
4	7	8	9	10	11	12							
5													
6	18	17	16	15	14	13							
7													
8	19	20	21	22	23	24							
9													
10	30	29	28	27	26	25							
11													
12	31	32	33	34	35	36							
13													

NOTE: Not more than 4 corners, all in the same town and range, may be recorded on this certificate.

A. Description of original monument and accessories and/or subsequent restoration:
F-5

- 1821 - G.L.O. Set 1/4 Post WIT: N50°W 4 Lks. Sugar; S65°W 12 Lks. Tree
- 1992 - Rowe Eng., Section Notes, Iron WIT: N10°E 40.80' P.K. Nail E. Face 8" Twin Oak; N90°E 6.54' P.K. Nail S.Face 15" Oak; South 29.07' P.K. Nail E.Face 12" Oak; S90°W 6.53' P.K. Nail S.Face 12" Twin Oak.

Distances:
 F-5 to G-5 = 2629.44' (G.L.O.); 2623.02' (Wade-Trim)
 F-5 to E-5 = 2629.44' (G.L.O.); 2617.24' (Wade-Trim)
 F-5 to E.Bank of Flint River = 73.9' (1.12 CH) G.L.O.; 72' (Wade-Trim)

B. Description of corner evidence found and/or method applied in restoring or reestablishing corner:

F-5 Found 1/2" Iron Rod

- WIT: N10°E 40.83' Fnd P.K. Nail E.Face 8" Twin Oak
 N90°E 6.53' Fnd P.K. Nail S. Face 15" Oak
 South 29.09' Fnd P.K. Nail E. Face 12" Oak
 S90°W 6.56' Fnd P.K. Nail S.Face 12" Twin Oak


accordance with Act 74, 1970
 Co. Rep. Carl Caban
 Date 10-30-96

The monument found was ratified by Peer Review Committee on October 30, 1996, as the accepted corner.

C. Description of monument for corner and accessories established to perpetuate locating the position of the corner:

F-5 Set 2" X 30" Iron Pipe with Brass Genesee Co. Remon Cap

- WIT: N75°W 6.63' Set 60d Nail/ Genesee Remon Tag S.Face 8" & 12" Twin Oak
 N80°E 6.69' Set 60d Nail/ Genesee Remon Tag S.Face 12" R.Oak
 S05°W 29.17' Set 60d Nail/ Genesee Remon Tag E.Face 12" Poplar
 S35°W 37.49' Set 60d Nail/ Genesee Remon Tag NW Face 8" Elm
 S30°E 11.41' Set 60d Nail/ Genesee Remon Tag SW Face Fence Post
 East 7' Fence corner (Fence running East & South)

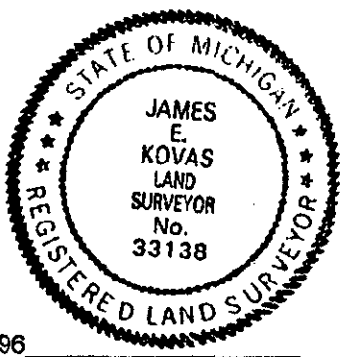

Signed by James E. Kovas Date December 20, 1996

Surveyor's Michigan License No. 33138