

SURVEY & REMONUMENTATION

MAY 31 2000

SECTION

**1996 Remonumentation Program
LAND CORNER RECORDATION CERTIFICATE
Filing Requirement of Act 74, Mich. P.A. 1970**

MASTER LIBER 3434 PAGE 298

RECORDED
REGISTERED
DEC 23 2 07 PM '96

*9.00
filed
rec*

82435

Register of Deeds Stamp & File Number

For corners in
Genesee
(county)

Located In:	Corner Code #
T 8N R 8E	G-4
T R	
T R	
T R	
T R	
S T R	
S T R	
S T R	
S T R	

- Public Land Survey
- Property Controlling in Section
- Miscellaneous Property in Sec.

4. Lot No. _____, Recorded Plat _____

5. Private Claims _____

I, James E. Kovas, in a field survey on September 24, 1996 do hereby certify that under requirements of P.A. 74, Michigan P.A. of 1970, the corner points mentioned in lines 1 and 2 above were in conformance with regulations and rules therefore as required in the current manual of survey instructions of the United States Department of the Interior, Bureau of Land Management or by a decree of a Court of Law and/or that the corner points mentioned in lines 3, 4 and 5 above were in conformance with the rules of the Michigan Board of Land Surveyors or by a Decree of a Court of Law; established, re-established, monumented, re-monumented, recovered, found as expressed below:

	A	B	C	D	E	F	G	H	I	J	K	L	M
2	6	5	4	3	2	1							
3													
4	7	8	9	10	11	12							
5													
6	18	17	16	15	14	13							
7													
8	19	20	21	22	23	24							
9													
10	30	29	28	27	26	25							
11													
12	31	32	33	34	35	36							
13													

NOTE: Not more than 4 corners, all in the same town and range, may be recorded on this certificate.

A. Description of original monument and accessories and/or subsequent restoration:

G-4
1821 - G.L.O. Set 1/4 Post WIT: N73°E 29 Lks. Sugar Maple; S71°W 33 Lks. 6" Elm
1965 - Consumers Power Co., Monument Box under Bit., four (4) accessories; 1973 - Genesee Co. Road Comm., Monument Box, three (3) accessories; 1974 - Consumers Power Co. (Liber 1888, Page 117), Monument Box under Bit., no accessories; 1977 - Rowe Eng., Iron Nail, no accessories; 1978 - CHMP (Liber 2016, Page 173) T-Iron in Mon. Box., five (5) accessories; 1991 - Rowe Eng. (Liber 2045, Page 542) no accessories; 1991 - Rowe Eng., T-Iron in Mon Box (Liber 2444, Page 972-974) five (5) accessories.
Distances: G-4 to G-3 = 2640.00' (G.L.O.); 2613.81' (1974); 2614.11' (1991); 2614.06' (1996)
G-4 to G-5 = 2640.00' (G.L.O.); 2637.00' (1974); 2636.51' (1996)

B. Description of corner evidence found and/or method applied in restoring or reestablishing corner:

G-4 Found T-Iron in Monument Box (0.5' below bit. grade)
Found 1-1/4" Iron Bar (0.04' South & 0.02' West of T-Iron location, 2.3' below bit. grade)


WIT: N45°E 57.50' Fnd Nail/ Tag# 20709 NW Face 32" Elm
East 2.2' Fnd physical centerline of M-15 (N-S)
S50°W 74.5' Fnd Fence Post
N55°E 55.27' Fnd Nail/ Tag# 20709 NNW Face 12" Maple
N88°W 58.34' Fnd Nail/ Tag# 20709 S.Face U.Pole

Ratified by Peer Group in accordance with P.A. 345, 1990
Co. Rep. Carl Carlson
Date 10-9-96

The 1-1/4" Iron Bar found was ratified by Peer Review Committee on October 9, 1996, as the accepted corner.

C. Description of monument for corner and accessories established to perpetuate locating the position of the corner:

G-4 Set 2" X 30" Iron Pipe with Brass Genesee Co. Remon Cap
WIT: N45°E 57.50' Set 60d Nail/ Genesee Remon Tag NW Face 32" Elm
N88°E 63.48' Set 60d Nail/ Genesee Remon Tag N.Face 8" Elm
N88°W 58.34' Set 60d Nail/ Genesee Remon Tag S.Face U.Pole
S80°W 36.65' NE corner of storm runoff structure (5' X 5' X 3' above ground)

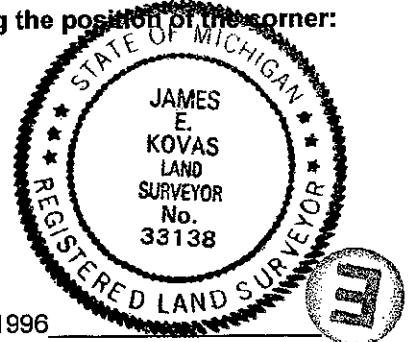

Signed by James E. Kovas Date December 20, 1996

Surveyor's Michigan License No. 33138