

MAY 31 2000


SECTION \_\_\_\_\_

1996 Remonumentation Program  
**LAND CORNER RECORDATION CERTIFICATE**  
 Filing Requirement of Act 74, Mich. P.A. 1970

MASTER LIBER 3434 PAGE 300

For corners in

_____ Genesee _____	Located In:	Corner Code #
(county)		
1. Public Land Survey	T 8N R 8E	H-5
	T _____ R _____	_____
	T _____ R _____	_____
	T _____ R _____	_____
2. Property Controlling in Section	S _____ T _____ R _____	_____
	S _____ T _____ R _____	_____
3. Miscellaneous Property in Sec.	S _____ T _____ R _____	_____
	S _____ T _____ R _____	_____
4. Lot No. _____, Recorded Plat _____		
5. Private Claims _____		

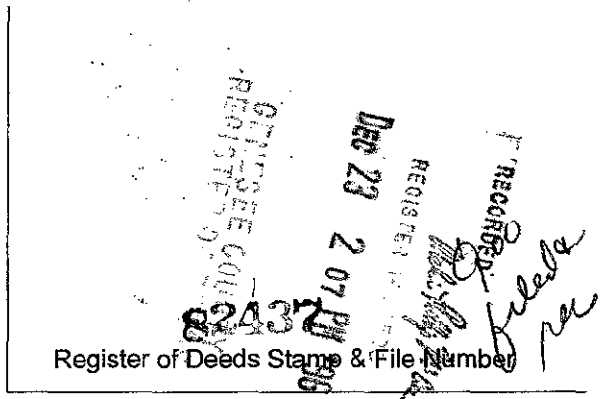

I, James E. Kovas, in a field survey on September 25, 1996, do hereby certify that under requirements of P.A. 74, Michigan P.A. of 1970, the corner points mentioned in lines 1 and 2 above were in conformance with regulations and rules therefore as required in the current manual of survey instructions of the United States Department of the Interior, Bureau of Land Management or by a decree of a Court of Law and/or that the corner points mentioned in lines 3, 4 and 5 above were in conformance with the rules of the Michigan Board of Land Surveyors or by a Decree of a Court of Law; established, re-established, monumented, re-monumented, recovered, found as expressed below:

	A	B	C	D	E	F	G	H	I	J	K	L	M
2	6	5	4	3	2	1							
3													
4	7	8	9	10	11	12							
5													
6	18	17	16	15	14	13							
7													
8	19	20	21	22	23	24							
9													
10	30	29	28	27	26	25							
11													
12	31	32	33	34	35	36							
13													

**NOTE: Not more than 4 corners, all in the same town and range, may be recorded on this certificate.**


- A. Description of original monument and accessories and/or subsequent restoration:**
- H-5 1821 - G.L.O. Set 1/4 Post WIT: S72°E 15 Lks. Ironwood; N10°W10Lks. Beech.
  - 1971 - Rowe Eng., Field Notes, Corner not in. WIT: South 33' Consumers T-Iron (from computed 1/4 corner location)
  - 1972 - Genesee Co. Road Comm., Section Notes, Square Iron in line with N-S Fence and center of bridge WIT: N45°W 41.28' Nail/Tag 8" Boxelder; N15°E 27.33' Nail/ Tree; N50°E 60.16' Nail Tree; SSE 34.9' Nail Tree; South 35.86' Nail/Tag Fence Post (E-W Fence line).
  - 1974 - Consumers Power Co., Section Notes, Square Iron in line with N-S Fence and center of bridge WIT: NE 60.12' 8" Maple; NNE 27.26' 6" Elm; South 34.85' Maple Clump.
  - 1982 - Joseph Wizynajty, PS#21595, LCRC (L.2205, P.356 & L.2276, P.379) WIT: North 20.9' N.End 48" C.M.P.; South 23.9' South End 48" C.M.P.
  - 1990 - Flint Surveying & Eng., Survey, no mon. Desc. WIT: NNE 27.2' Nail 16" Elm; NE 60.1' Nail 8" Maple; South 34.8' Nail in Maple Clump.

- B. Description of corner evidence found and/or method applied in restoring or reestablishing corner:**
- H-5 Found Gear Pin
  - WIT: South 33.3' Fnd Consumers Power Co. T-Iron
  - South 35.2' Fnd Rotted Base of Fence Post
  - North 20.5' Fnd N.End 48" C.M.P.
  - South 23.9' Fnd S.End 48" C.M.P.
  - N15°E 28.31' Fnd Nail E.Face 10" W.Oak

Ratified by Peer Group in accordance with P.A. 345, 1990  
 Co. Rep. Carl Lamm  
 Date 11-20-96

The monument found was ratified by Peer Review Committee on November 15, 1996, as the accepted corner.

- C. Description of monument for corner and accessories established to perpetuate locating the position of the corner:**
- H-5 Set 2" X 30" Iron Pipe with Brass Genesee County Remonumentation Cap at location of Gear Pin.
  - WIT: South 33.3' Fnd Consumers Power Co. T-Iron
  - North 20.5' N.End 48" C.M.P.
  - South 23.9' S.End 48" C.M.P.
  - S75°W Set 60d Nail/Genesee Co. Tag N.Face U.Pole
  - S05°W 118.40' NE Cor Base of NE Leg of High Tension Power line tower
  - N15°E Set 60d Nail/Genesee Co. Tag W.Face 12" Oak
  - N05°E Set 60d Nail/Genesee Co. Tag E.Face U.Pole
  - S60°E Set 60d Nail/Genesee Co. Tag NE Face U.Pole

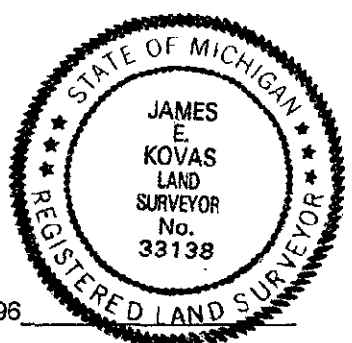

Signed by James E. Kovas Date December 20, 1996

Surveyor's Michigan License No. 33138

