

SURVEY & REMONUMENTATION

MAY 31 2000

SECTION _____

1996 Remonumentation Program
LAND CORNER RECORDATION CERTIFICATE
 Filing Requirement of Act 74, Mich. P.A. 1970


MASTER LIBER 3434 PAGE 302

For corners in Genesee (county)	Located In:	Corner Code #
1. Public Land Survey	T 8N R 8E	I-5
	T _____ R _____	_____
	T _____ R _____	_____
	T _____ R _____	_____
2. Property Controlling in Section	S _____ T _____ R _____	_____
	S _____ T _____ R _____	_____
3. Miscellaneous Property in Sec.	S _____ T _____ R _____	_____
	S _____ T _____ R _____	_____

REGISTER OF DEEDS
 REGISTERED
 RECORDED
 Dec 23 2 07 PM 1996
 82438
 Register of Deeds Stamp & File Number

4. Lot No. _____, Recorded Plat _____
5. Private Claims _____

I, James E. Kovas, in a field survey on September 23, 1996, do hereby certify that under requirements of P.A. 74, Michigan P.A. of 1970, the corner points mentioned in lines 1 and 2 above were in conformance with regulations and rules therefore as required in the current manual of survey instructions of the United States Department of the Interior, Bureau of Land Management or by a decree of a Court of Law and/or that the corner points mentioned in lines 3, 4 and 5 above were in conformance with the rules of the Michigan Board of Land Surveyors or by a Decree of a Court of Law; established, re-established, monumented, re-monumented, recovered, found as expressed below:

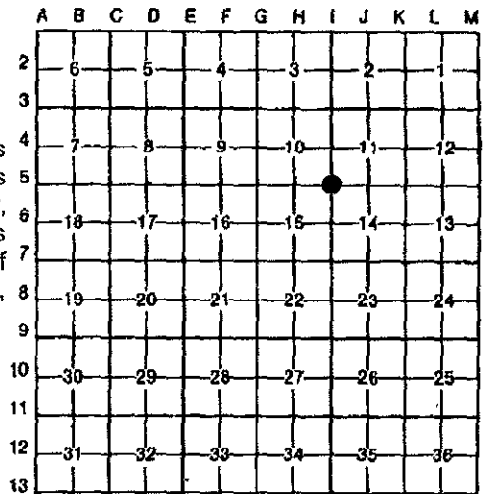

NOTE: Not more than 4 corners, all in the same town and range, may be recorded on this certificate.

A. Description of original monument and accessories and/or subsequent restoration:
 I-5

1821 - G.L.O. Set Corner WIT: S60°W 11 Lks. Elm; S72°E 28 Lks. Sugar; 1971 - Rowe Eng., Monument Box, no accessories; 1974 - Stanley Heights Subdivision (Liber 53 Plats, Page 15); 1974 - Gould Eng. (Liber 1890, Page 617) four (4) accessories; 1974 - Consumers Power Co. (Liber 1888, Page 117) Found Iron, four (4) accessories; 1978 - Rowe Eng., Iron, three (3) accessories; 1975 - A. Vance Kuisch, LCRC (Liber 1907, Page 209) four (4) accessories; 1981 - Elbex Harris, LCRC (Liber 2125, Page 124) Iron Pin, four (4) accessories; 1982 - Joseph Wizynajty, LCRC (Liber 2205, Page 356) 1/2" Re-Rod, three (3) accessories; 1985 - Flint Surveying & Eng. (Liber 2246, Page 464), no accessories.

Distances: I-5 to I-4 = 2640.00' (GLO); 2641.91' (Wade-Trim); I-5 to J-5 = 2636.04' (GLO); 2635.36' (Wade-Trim); I-5 to H-5 = 2623.84' (GLO); 2609.58' (Wade-Trim).

B. Description of corner evidence found and/or method applied in restoring or reestablishing corner:

I-5 Found 1/2" Iron Rod in Monument Box
 Found 1" Iron Rod (0.02' South & 0.11' East of location of 1/2" Iron)

Ratified by Peer Group in accordance with P.A. 345, 1990
 Co. Rep. [Signature]
 Date 10-9-96


WIT: S45°E 61.54' Fnd Nail/ Washer in U.Pole
 N45°W 49.15' Fnd County Road Sign
 N60°W 127.25' Fnd Nail/ Tag in P.Pole

The 1" Iron Rod found was ratified by Peer Review Committee on October 9, 1996, as the accepted corner.

C. Description of monument for corner and accessories established to perpetuate locating the position of the corner:

I-5 Set 2" X 30" Iron Pipe with Brass Genesee Co. Remon Cap

WIT: N50°W 114.73' Set 60d Nail/ Genesee Remon Tag SW Face 40" Willow
 N40°E 56.33' Set 60d Nail/ Genesee Remon Tag SW Face U.Pole
 S40°E 61.54' Set 60d Nail/ Genesee Remon Tag NE Face U.Pole
 S28°W 92.54' Set 60d Nail/ Genesee Remon Tag NW Face 18" Silver Maple

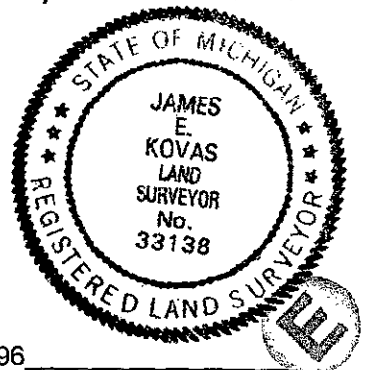

Signed by James E. Kovas Date December 20, 1996

Surveyor's Michigan License No. 33138