

MAY 20 1997

1996 Remonumentation Program
LAND CORNER RECORDATION CERTIFICATE
Filing Requirement of Act 74, Mich. P.A. 1970

MASTER LIBER 3434 PAGE 303

For corners in
Genesee

(county)	Located In:	Corner Code #
1. Public Land Survey	T 8N R 8E	J-5
	T R	
	T R	
	T R	
2. Property Controlling in Section	S T R	
	S T R	
3. Miscellaneous Property in Sec.	S T R	
	S T R	

82440
 REGISTERED
 RECORDED
 Dec 23 2 07 PM '96
 Register of Deeds Stamp & File Number

4. Lot No. _____, Recorded Plat _____

5. Private Claims _____

I, James E. Kovas, in a field survey on September 23, 1996, do hereby certify that under requirements of P.A. 74, Michigan P.A. of 1970, the corner points mentioned in lines 1 and 2 above were in conformance with regulations and rules therefore as required in the current manual of survey instructions of the United States Department of the Interior, Bureau of Land Management or by a decree of a Court of Law and/or that the corner points mentioned in lines 3, 4 and 5 above were in conformance with the rules of the Michigan Board of Land Surveyors or by a Decree of a Court of Law; established, re-established, monumented, re-monumented, recovered, found as expressed below:

	A	B	C	D	E	F	G	H	I	J	K	L	M
2	6		5		4		3		2		1		
3													
4	7		8		9		10		11		12		
5													
6	18		17		16		15		14		13		
7													
8	19		20		21		22		23		24		
9													
10	30		29		28		27		26		25		
11													
12	31		32		33		34		35		36		
13													

NOTE: Not more than 4 corners, all in the same town and range, may be recorded on this certificate.

A. Description of original monument and accessories and/or subsequent restoration:

J-5
 1821 - G.L.O. Set 1/4 Post WIT: N78°E 1 Lk. Maple; N60°W 11 Lks. Elm; 1965 - Genesee Co. Road Comm., T-Iron, three (3) accessories; 1978 - Rowe Eng., T-Iron, three (3) accessories; 1975 - American Civil Engineers, Monument Box Sealed, four (4) accessories; 1981 - Elbex Harris, LCRC (Liber 2125, Page 124) T-Iron, three (3) accessories; Davis Land Surveying (Liber 2236, Page 264) 1/2" Iron Rod in Monument Box, four (4) accessories.

Distances: J-5 to I-5 = 2636.04' (GLO); 2635.36' (Wade-Trim)
 J-5 to K-5 = 2636.04' (GLO); 2646.30' (Wade-Trim)

B. Description of corner evidence found and/or method applied in restoring or reestablishing corner:

J-5 Found 3/4" Iron Pipe in Monument Box

WIT: North 2.0' physical centerline Stanley Road (East-West)
 South 32.65' P.K. Nail/ Flagging N.Face Fence Post


Ratified by Peer Group in accordance with P.A. 345, 1990
 Co. Rep. Carl Carlson
 Date 10-9-96

The 3/4" Iron Pipe found was ratified by Peer Review Committee on October 9, 1996, as the accepted corner.

C. Description of monument for corner and accessories established to perpetuate locating the position of the corner:

J-5 Set 2" X 30" Iron Pipe with Brass Genesee Co. Remon Cap

WIT: N03°E 81.97' Set 60d Nail/ Genesee Remon Tag 30" Willow
 N08°E 52.94' Set 60d Nail/ Genesee Remon Tag E.Face U.Pole
 S85°W 146.55' Set 60d Nail/ Genesee Remon Tag N.Face 18" Maple
 S78°E 100.32' Set 60d Nail/ Genesee Remon Tag N.Face 15" Elm

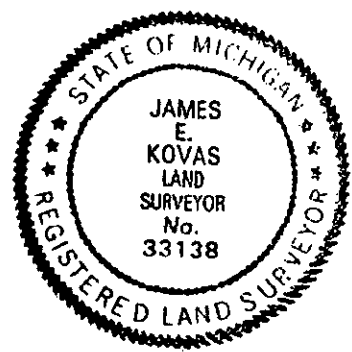

Signed by James E. Kovas Date December 20, 1996

Surveyor's Michigan License No. 33138