

MAY 31 2000


SECTION

1996 Remonumentation Program
LAND CORNER RECORDATION CERTIFICATE ^{MASTER} ^{LIBER} 3434 PAGE 304
Filing Requirement of Act 74, Mich. P.A. 1970

For corners in
Genesee
_____ (county)

Located In: Corner Code #

- | | | |
|------------------------------------|-------------------------|-------|
| 1. Public Land Survey | T 8N R 8E | K-4 |
| | T _____ R _____ | _____ |
| | T _____ R _____ | _____ |
| | T _____ R _____ | _____ |
| 2. Property Controlling in Section | S _____ T _____ R _____ | _____ |
| | S _____ T _____ R _____ | _____ |
| 3. Miscellaneous Property in Sec. | S _____ T _____ R _____ | _____ |
| | S _____ T _____ R _____ | _____ |

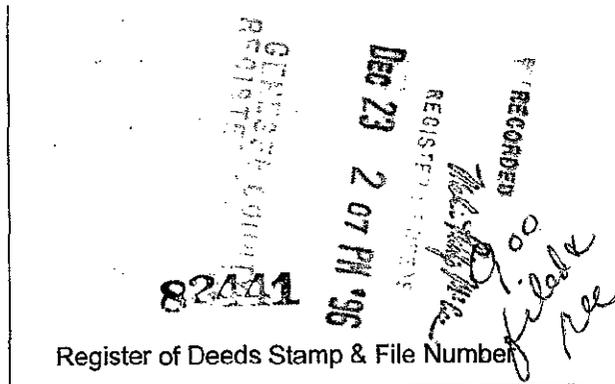

4. Lot No. _____, Recorded Plat _____

5. Private Claims _____

I, James E. Kovas, in a field survey on September 25, 1996, do hereby certify that under requirements of P.A. 74, Michigan P.A. of 1970, the corner points mentioned in lines 1 and 2 above were in conformance with regulations and rules therefore as required in the current manual of survey instructions of the United States Department of the Interior, Bureau of Land Management or by a decree of a Court of Law and/or that the corner points mentioned in lines 3, 4 and 5 above were in conformance with the rules of the Michigan Board of Land Surveyors or by a Decree of a Court of Law; established, re-established, monumented, re-monumented, recovered, found as expressed below:

	A	B	C	D	E	F	G	H	I	J	K	L	M
2	6	5	4	3	2	1							
3													
4	7	8	9	10	11	12							
5													
6	18	17	16	15	14	13							
7													
8	19	20	21	22	23	24							
9													
10	30	29	28	27	26	25							
11													
12	31	32	33	34	35	36							
13													

NOTE: Not more than 4 corners, all in the same town and range, may be recorded on this certificate.

A. Description of original monument and accessories and/or subsequent restoration:
K-4

1821 - G.L.O. Set 1/4 Post WIT: N63°E 14 Lks. Elm; S44°W 14 Lks. Beech; 1965 - Genesee Co. Road Comm., Iron Pin and Stone, five (5) accessories; 1975 - American Civil Engineers (Liber 1933, Page 785), no accessories; 1978 - Rowe Eng., Iron Pin and Stone, five (5) accessories; 1985 - Davis Land Surveying (Liber 2236, Page 264) 1" Iron, three (3) accessories.

Distances: K-4 to K-5 = 2640.00' (GLO); 2638.57' (Wade-Trim)

B. Description of corner evidence found and/or method applied in restoring or reestablishing corner:

K-4 Found 1/2" Iron Rod in small hole in bituminous pavement
Found 1" Iron Rod (same location below 1/2" Iron Rod)

WIT: N20°E 95.60' Fnd 36" Maple
SE 74.25' Fnd 36" R.Oak
N45°W 46.23' Fnd 22" Hickory
East 49.60' Fnd 8" Steel Post


Ratified by Peer Group in accordance with P.A. 345, 1990
Co. Rep. Carl Carlson
Date 11-6-96

The 1" Iron Rod found was ratified by Peer Review Committee on October 9, 1996, as the accepted corner.

C. Description of monument for corner and accessories established to perpetuate locating the position of the corner:

K-4 Set 2" X 30" Iron Pipe with Brass Genesee Co. Remon Cap

WIT: N45°W 46.23' Set 60d Nail/ Genesee Remon Tag E.Face 22" Hickory
S70°W 64.23' Set 60d Nail/ Genesee Remon Tag NW Face 6" Hickory
N70°E 35.00' Set 60d Nail/ Genesee Remon Tag S.Face 8" Maple
S30°E 74.25' Set 60d Nail/ Genesee Remon Tag W.Face 36" Oak

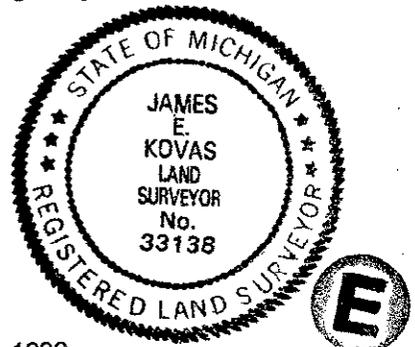

Signed by James E. Kovas Date December 20, 1996

Surveyor's Michigan License No. 33138