

SURVEY & REMONUMENTATION

MAY 31 2000

SECTION

1996 Remonumentation Program
LAND CORNER RECORDATION CERTIFICATE
 Filing Requirement of Act 74, Mich. P.A. 1970

MASTER LIBER 3434 PAGE 305

For corners in

Genesee (county)	Located In:	Corner Code #
1. Public Land Survey	T 8N R 8E	K-5
	T R	
	T R	
	T R	
2. Property Controlling in Section	S T R	
	S T R	
3. Miscellaneous Property in Sec.	S T R	
	S T R	

REGISTERED
 REGISTER OF DEEDS
 Dec 23 2 07 PM '96
 82442
 Register of Deeds Stamp & File Number

4. Lot No. _____, Recorded Plat _____
 5. Private Claims _____

	A	B	C	D	E	F	G	H	I	J	K	L	M
2	6		5		4		3		2		1		
3													
4	7		8		9		10		11		12		
5													
6	18		17		16		15		14		13		
7													
8	19		20		21		22		23		24		
9													
10	30		29		28		27		26		25		
11													
12	31		32		33		34		35		36		
13													

I, James E. Kovas, in a field survey on September 24, 1996, do hereby certify that under requirements of P.A. 74, Michigan P.A. of 1970, the corner points mentioned in lines 1 and 2 above were in conformance with regulations and rules therefore as required in the current manual of survey instructions of the United States Department of the Interior, Bureau of Land Management or by a decree of a Court of Law and/or that the corner points mentioned in lines 3, 4 and 5 above were in conformance with the rules of the Michigan Board of Land Surveyors or by a Decree of a Court of Law; established, re-established, monumented, re-monumented, recovered, found as expressed below:

NOTE: Not more than 4 corners, all in the same town and range, may be recorded on this certificate.

A. Description of original monument and accessories and/or subsequent restoration:

K-5 1821 - G.L.O. Set Corner two (2) accessories; 1965 - Genesee Co. Road Comm, Iron Driven into Stone two (2) accessories; 1973 - Flint Surveying & Eng., Pot with Iron (L.1895, P.999) three (3) accessories; 1973 - Rowe Eng., 1/4" Re-Rod in Mon. Box (L.1861, P.237) three (3) accessories; 1973 - Flint Surveying & Eng. Iron Rod in Mon. Box (L. 1896, P.1) three (3) accessories; 1973 - Flint Surveying & Eng. 1/2" Re-Rod three (3) accessories; 1975 - American Civil Engineers, Mon Box Sealed (L.1933, P.785) three (3) accessories; 1985 - Davis Land Surveying, Mon. Box Sealed (L. 2236, P.264) three (3) accessories; 1986 - Rowe Eng., Re-Rod in Mon. Box, four (4) accessories; 1986 - Joseph Wizynajty, PS#21585 (L.2316, P.272), 3/8" Re-Rod in Mon. Box, four (4) accessories; 1986 - Cornerstone Surveying & Eng., Survey, 3/8" Re-Rod in Mon. Box, four (4) accessories.

Distances: K-5 to K-4 = 2640.00' G.L.O. 1821; 2638.57' Wade-Trim, 1996.
 K-5 to L-5 = 2680.60' G.L.O. 1821; 2645.46' Rowe, 1986; 2645.55' Wade-Trim, 1996.
 K-5 to K-6 = 2640.00' G.L.O. 1821; 2665.08' Rowe, 1986.
 K-5 to J-5 = 2636.04' G.L.O. 1821; 2646.30' Wade-Trim, 1996.

B. Description of corner evidence found and/or method applied in restoring or reestablishing corner:


K-5 Found 1/2" Iron Rod in Monument Box
 WIT: N45°E 71.74' Fnd P.K.Nail in U.Pole
 S45°W 41.50' Fnd P.K. Nail in Conc. Post
 N45°W 60.93' Fnd Nail/Tag# 11192 U.Pole

Ratified by Peer Group in accordance with P.A. 345, 1990
 Co. Rep. [Signature]
 Date 10-9-96

The monument found was ratified by Peer Review Committee on October 15, 1996, as the accepted corner.

C. Description of monument for corner and accessories established to perpetuate locating the position of the corner:

K-5 Set 2" X 30" Iron Pipe with Brass Genesee County Remonumentation Cap at location of 1/2" Iron Rod
 WIT: N45°E 71.74' Fnd P.K.Nail in U.Pole
 S45°W 41.50' Fnd P.K. Nail in Conc. Post
 N45°W 60.93' Fnd Nail/Tag# 11192 U.Pole
 N50°W 50.15' Set 60d Nail/Genesee Co. Tag SW Face 15" Elm
 S50°W 48.02' Set 60d Nail/Genesee Co. Tag N.Face 18" Oak
 S40°E 47.21' Set 60d Nail/Genesee Co. Tag NE Face 15" Elm
 N50°E 71.74' Set 60d Nail/ Genesee Co. Tag NE Face U.Pole
 N35°W 60.93' Set 60d Nail/Genesee Co. Tag E.Face U.Pole

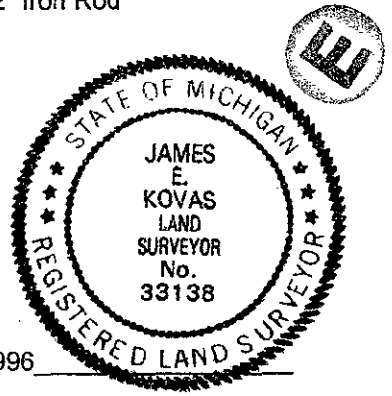

Signed by James E. Kovas Date December 20, 1996

Surveyor's Michigan License No. 33138