

SURVEY & REMONUMENTATION

MAR 23 2000

**1999 GENESEE COUNTY REMONUMENTATION PROGRAM
LAND CORNER RECORDATION CERTIFICATE
Filing Requirement of Act 74, Mich. P.A. 1970**

SECTION

For corners in

<u>Genesee</u> (County)	Located in: Richfield	Corner Code #
1. Public Land Survey	T8N R8E	K-6
	T R	
	T R	
	T R	
2. Property Controlling in Section	S T R	
	S T R	
3. Miscellaneous Property in Sec.	S T R	
	S T R	
4. Lot No. _____, Recorded Plat _____		
5. Private Claims _____		

MASTER LIBER 4355 PAGE 107

DEC 21 3 10 PM '99

109075

Filed & Rec 9:00
Register of Deeds Stamp & File Number

I, Kevin B. Cleaver, in a field survey on December 1, 1999, do hereby state that under requirements of P.A. 74, Michigan P.A. of 1970, the corner points mentioned in lines 1 and 2 above were in conformance with regulations and rules therefore as required in the current manual of survey instructions of the United States Department of the Interior, Bureau of Land Management or by a decree of a Court of Law and for that the corner points mentioned in lines 3, 4 and 5 above were in conformance with the rules of the Michigan Board of Land Surveyors or by a Decree of a Court of Law; established, re-established, monumented, recovered, found as expressed below:

NOTE: Not more than 2 corners, all in the same town and range, may be recorded on this certificate.

A. Description of original monument and accessories and/or subsequent restoration:

- 1822 General Land Office (GLO) field notes: set post w/two accessories
- December, 1864 Genesee County survey notes: measurement to 1/16th line
- 1921 Genesee County Road Commission (GCRC) plans: half-mile measurements
- 4/19/73 P.A. 132 Certified Survey, Liber 1895, Page 999: rail road spike w/three accessories and measurements to section corner
- 5/23/73 P.A. 132 Certified Survey, Liber 1861, Page 237: rail road spike w/three accessories and measurements to section corner
- 8/29/73 P.A. 132 Certified Survey, Liber 1877, Page 850: rail road spike and half-mile measurement
- 6/1/74 P.A. 132 Certified Survey, Liber 1896, Page 758: rail road spike w/three accessories, half-mile measurement, and measurements to section corner
- 6/26/74 Land Corner Recordation Certificate (LCRC), Liber 1893, Page 97: rail road spike w/three accessories
- 7/19/74 P.A. 132 Certified Survey, Liber 1898, Page 128: "T"-iron and half-mile measurements
- 8/10/77 P.A. 132 Certified Survey, Liber 1987, Page 834: rail road spike w/three accessories and measurement to section corner
- 4/6/78 P.A. 132 Certified Survey, Liber 2001, Pages 524-525: rail road spike w/three accessories and measurements to section corner
- 9/17/86 P.A. 132 Certified Survey, Liber 2271, Pages 940-943: rail road spike w/four accessories

B. Description of corner evidence found and/or method applied in restoring or reestablishing corner:


- GLO corner and accessories not found
- Confirmed half-mile split from 1864 notes
- Confirmed within acceptable tolerance half-mile measurements from 1921 GCRC plans
- Recovered corner, two accessories, and confirmed measurements to section corner from 4/19/73 certified survey
- Recovered corner, two accessories, and confirmed measurements to section corner from 5/23/73 certified survey
- Confirmed half-mile measurement from 8/29/73 certified survey
- Recovered corner, two accessories, and confirmed half-mile measurement and measurements to section corner from 6/1/74 certified survey
- Recovered corner and two accessories from 6/26/74 certified survey
- Determined position of iron set in 7/19/74 certified survey to be in error
- Recovered corner, one accessory, and confirmed measurement to section corner from 1977 certified survey
- Recovered corner, two accessories, and confirmed measurements to section corner
- Recovered corner and two accessories from 1986 certified survey
- This monument found was ratified by the Genesee County Remonumentation Peer Review Committee on November 24, 1999.

C. Description of monument for corner and accessories established to perpetuate locating the position of the corner:

- Set the standard Bernsten monument SS-A-5BR-30 with 3 1/4" brass cap stamped "Genesee County Remonumentation Corner, 1999, #29242" on top of railroad spike
- N 19° E 102.96' set Genesee County witness tag in top of 12" concrete pillar
- S 71° E 47.00' set Genesee County witness tag in south face power pole
- S 86° W 46.49' set Genesee County witness tag in north face 9" deciduous
- N 46° W 61.04' set Genesee County witness tag in north face 13" blue spruce

Signed by Kevin B. Cleaver
Surveyor's Michigan License No. 29242

Date 12/20/99

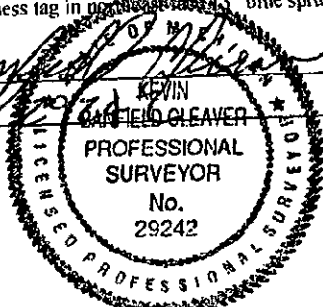

FORM APPROVED BY MICHIGAN STATE BOARD OF PROFESSIONAL SURVEYORS, JAN. 28, 1971
REVISED MAY 14, 1975
REVISED JAN., 1983
REVISED OCT., 1995

Ratified by Peer Group in accordance with P.A. 345, 1990

Co. Rep. Carl Carlson
Date 11-24-99