

MAY 20 1997

1996 Remonumentation Program
LAND CORNER RECORDATION CERTIFICATE
Filing Requirement of Act 74, Mich. P.A. 1970

MASTER LIBER 3434 PAGE 306

For corners in

_____ Genesee _____ (county)	Located In:	Corner Code #
1. Public Land Survey	T 8N R 8E	L-5
	T _____ R _____	_____
	T _____ R _____	_____
	T _____ R _____	_____
2. Property Controlling in Section	S _____ T _____ R _____	_____
	S _____ T _____ R _____	_____
3. Miscellaneous Property in Sec.	S _____ T _____ R _____	_____
	S _____ T _____ R _____	_____

82443
Dec 23 2 07 PM '96
REGISTERED
RECORDED
Register of Deeds Stamp & File Number

4. Lot No. _____, Recorded Plat _____

5. Private Claims _____

I, James E. Kovas, in a field survey on September 23, 1996, do hereby certify that under requirements of P.A. 74, Michigan P.A. of 1970, the corner points mentioned in lines 1 and 2 above were in conformance with regulations and rules therefore as required in the current manual of survey instructions of the United States Department of the Interior, Bureau of Land Management or by a decree of a Court of Law and/or that the corner points mentioned in lines 3, 4 and 5 above were in conformance with the rules of the Michigan Board of Land Surveyors or by a Decree of a Court of Law; established, re-established, monumented, re-monumented, recovered, found as expressed below:

A	B	C	D	E	F	G	H	I	J	K	L
2	6		5		4		3		2		1
3											
4	7		8		9		10		11		12
5											
6	13		17		16		15		14		13
7											
8	19		20		21		22		23		24
9											
10	30		29		28		27		26		25
11											
12	31		32		33		34		35		36
13											

NOTE: Not more than 4 corners, all in the same town and range, may be recorded on this certificate.

A. Description of original monument and accessories and/or subsequent restoration:

- L-5 1821 - G.L.O. Set 1/4 Post WIT: S20W 6 Lks. Pine; N26W 17 Lks. W.Oak
 - 1965 - Genesee Co. Road Comm., Section Notes, 3/4" Iron Pipe, four (4) accessories.
 - 1973 - Flint Surveying & Eng., (L. 1896, P. 1) 1" Iron Rod in Mon. Box, three (3) accessories.
 - 1978 - Rowe Eng., Section Notes, 3/4" Iron Pipe, four (4) accessories.
 - 1986 - Rowe Eng., Survey (L. 2271, P.943), 1/2" Iron Rod in Mon. Box, four (4) accessories.
 - 1986 - Cornerstone Surveying & Eng., (L. 2336, P. 103), four (4) accessories.
 - 1986 - Joseph A. Wizynajty, PS# 21585, LCRC (L. 2316, P. 272), three (3) accessories.
- Distances: L-5 to K-5 = 2680.60' (GLO); 2645.46' (Rowe); 2645.55' (Wade-Trim);

B. Description of corner evidence found and/or method applied in restoring or reestablishing corner:


- L-5 Found 3/4" Iron Rod in Monument Box
- WIT: N15°E 52.75' Fnd Nail/ Tag in SSE Face P.Pole
- N45°W 99.15' Fnd P.Pole
- South 32.25' Fnd P.K.Nail in E. Face Fence Post
- S60°W 74.43' Fnd Nail/ Flagging N.Face 10" Shag Bark Hickory
- N45°W 26.12' Fnd Capped Rowe Iron (Liber 2271, Page 943)

Ratified by Peer Group in accordance with P.A. 345, 1980
Co. Rep. Callahan
Date 10-9-96

The monument found was ratified by the Peer Review Committee on November 6, 1996, as the approved corner.

C. Description of monument for corner and accessories established to perpetuate locating the position of the corner:

- L-5 Set 2" X 30" Iron Pipe with Brass Genesee County Remonumentation Cap at location of 3/4" Iron Rod.
- WIT: N15°E 52.75' Set 60d Nail/ Genesee Co. Tag SSE Face U.Pole
- N45°W 99.15' Set 60d Nail/ Genesee Co. Tag SW Face P.Pole
- South 32.25' Fnd P.K. Nail in E.Face Fence Post
- S60°W 74.43' Fnd Nail/ Flagging 10" Shag Bark Hickory
- N45°W 26.12' Fnd Capped Rowe Iron (Liber 2271, Page 943)

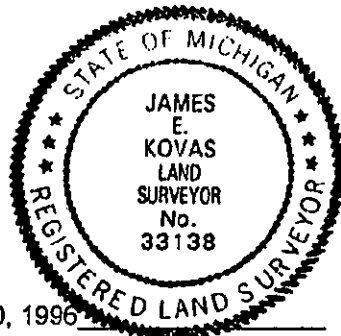

Signed by James E. Kovas Date December 20, 1996

Surveyor's Michigan License No. 33138