

REMONUMENTATION CORNER UNDER ACT 345, MICHIGAN PUBLIC ACTS OF 1990

LAND CORNER RECORDATION CERTIFICATE

Filing Requirement of Act 74, Mich. P.A. 1970

For corners in  
GENESEE  
(County)

Located in: Montreal Corner Code #:

1. Public Land Survey	T	9N	R	5E	F-3
	T		R		
	T		R		
	T		R		
2. Property Controlling in Section	S	T	R		
	S	T	R		
3. Miscellaneous Property in Sec.	S	T	R		
	S	T	R		

RECORDED  
REGISTERED OF  
Dec 27 9 21 AM '93  
GENESEE COUNTY  
FLINT MICHIGAN  
77959  
FILED & RECORDED  
Register of Deeds Stamp & File Number

4. Lot No. \_\_\_\_\_, Recorded Plat \_\_\_\_\_  
5. Private Claims \_\_\_\_\_

A	B	C	D	E	F	G	H	I	J	K	L	M
2	6	5	4	3	2							
3												
4	7	6	5	4	3	2	1					
5												
6	18	17	16	15	14	13						
7												
8	19	20	21	22	23	24						
9												
10	30	29	28	27	26	25						
11												
12	31	32	33	34	35	36						
13												

I, DONALD G. RICHARDS in a field survey on December 3, 19 93 do hereby certify that under requirements of P.A. 74, Michigan P.A. of 1970, the corner points mentioned in lines 1 and 2 above were in conformance with regulations and rules theretofore as required in the current manual of survey instructions of the United States Department of the Interior, Bureau of Land Management or by a decree of a Court of Law and/or that the corner points mentioned in lines 3, 4 and 5 above were in conformance with the rules of the Michigan Board of Land Surveyors or by a Decree of a Court of Law; established, re-established, monumented, re-monumented, recovered, found as expressed below:

NOTE: Not more than 4 corners, all in the same town and range, may be recorded on this certificate.

A. Description of original monument and accessories and/or subsequent restoration:

John Mullett  
Thursday, April 25th, 1839  
Set qr section post  
Pine 40 S 84 E 19  
(see reverse side for additional information)

B. Description of corner evidence found and/or method applied in restoring or reestablishing corner:

Found "T" iron

SURVEY & REMONUMENTATION


MAR 16 1994

COMMISSION



C. Description of monument for corner and accessories established to perpetuate locating the position of the corner:

Set Bernsten monument SS-A5BR-30 stamped "Genesee County Remonumentation Corner" over "T" iron  
S 65 W 54.94' nail/GCWT\* in N side twin 14" deciduous  
S 05 W 65.57' nail/GCWT in W side 20" Scotch Pine  
S 30 E 38.45' nail/GCWT in E side 18" Scotch Pine  
N 80 E 40.50' nail/GCWT in S side 14" Red Pine  
WEST 2638.72 section corner E-3, T9N-R5E  
EAST 2638.01 section corner G-3, T9N-R5E  
(\* Genesee County Witness Tag)

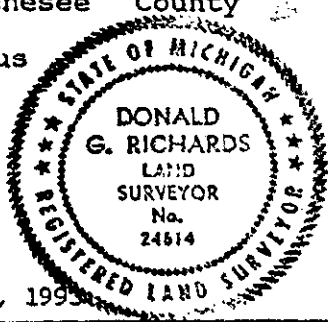

Signed by DONALD G. RICHARDS Date December 10, 1993

Surveyor's Michigan License No. 24614

APPROVED by Genesee County Monumentation Peer Group 11-04-93

GCRC TIES

No. 150: Set 24" Iron T Bar flush with ground (Brewer Engr. for  
CPCO) N 60 W 18.59 10" Linden  
S 50 W 54.08 12" Twin Linden  
S 15 W 124.68 Fence Post

PA 74

pg 29 (1901/512) Arthur W. Leach 10-30-74  
Found T-iron  
S 15 W 124.63 iron fence post at angle in fence line  
N 60 W 18.59 to nearest clump of 10" Linden trees  
S 50 W 54.68 12" Linden tree

PA 132 SURVEYS

1904/114-115: Arthur W. Leach 12-11-74  
"Found T-iron"  
" F-3 Liber 1901/512-513"

1961/980-987: Robert J. Tommer Jr. 1-21-77  
"F-3 Found T-iron  
S 15 W 124.68 Iron Fence Post at angle in fenceline  
N 60 W 18.59 clump of 10" Linden trees  
S 50 W 54.08 12" Linden tree"