

REMONUMENTATION CORNER UNDER ACT 345, MICHIGAN PUBLIC ACTS OF 1990

LAND CORNER RECORDATION CERTIFICATE
Filing Requirement of Act 74, Mich. P.A. 1970

For corners in
GENESEE
County:

Located in: Monkton Corner Code: #

- 1. Public Land Survey T 9N R 5E H-3
- T R
- T R
- T R
- 2. Property Controlling S T R
- in Section S T R
- 3. Miscellaneous S T R
- Property in Sec. S T R

- 4. Lot No. _____, Recorded Plat _____
- 5. Private Claims _____

RECORDED
REGISTERED
GENESEE COUNTY
FLINT MICHIGAN
DEC 27 9 11 AM '93
77977

FILED & RECORDED
Register of Deeds Stamp & File Number

I, DONALD G. RICHARDS, in a field survey on December 22nd, 19 93

do hereby certify that under requirements of P.A. 74, Michigan P.A. of 1970, the corner points mentioned in lines 1 and 2 above were in conformance with regulations and rules theretore as required in the current manual of survey instructions of the United States Department of the Interior, Bureau of Land Management or by a decree of a Court of Law and/or that the corner points mentioned in lines 3, 4 and 5 above were in conformance with the rules of the Michigan Board of Land Surveyors or by a Decree of a Court of Law, established, re-established, monumented, re-monumented, recovered, found as expressed below:

NOTE: Not more than 4 corners, all in the same town and range, may be recorded on this certificate.

A	B	C	D	E	F	G	H	I	J	K	L	M
2	6	5	4	3	2	1						
3												
4	7	8	9	10	11	12						
5												
6	18	17	16	15	14	13						
7												
8	19	20	21	22	23	24						
9												
10	30	29	28	27	26	25						
11												
12	31	32	33	34	35	36						
13												

A. Description of original monument and accessories and/or subsequent restoration:

Horatio Ball/Hervey C. Parke
Saturday, November 17th, 1821
West on account of of Reserve 40.00
Set 1/4 S. Post
Elm 12 N 83 E 12
B. Ash 7 S 62 W 15
(see reverse side for additional information)


B. Description of corner evidence found and/or method applied in restoring or reestablishing corner:

Found "T" iron in approximate center of E/W running gravel road

SURVEY &
REMONUMENTATION
MAR 16 1994
COMMISSION

C. Description of monument for corner and accessories established to perpetuate locating the position of the corner:

Set Bernsten monument SS-A5BR-30 stamped "Genesee County Remonumentation Corner" over "T" iron
S 20 W 29.78' nail/GCWT* in top of 24" stump
N 60 W 198.16' nail/GCWT in S face power pole
N 60 E 329.84' SW corner of brick dwelling
S 80 E 293.51' nail/GCWT in SW face power pole
WEST 2667.66' section corner G-3, T9N-R5E
WEST 552.82' SE corner Gov't. Lot 6, Sec. 3, T9N-R5E
EAST 2648.84' section corner I-3, T9N-R5E
(* Genesee County Witness Tag)

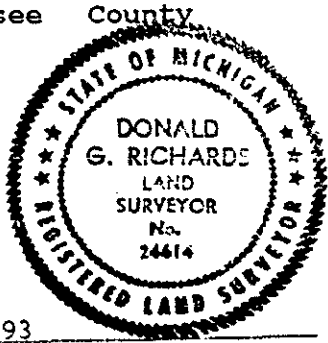

Signed by DONALD G. RICHARDS Date December 23, 1993
Surveyor's Michigan License No. 24614
APPROVED by Genesee County Monumentation Peer Group 12-21-93

GCRC TIES

No. 156: Set Iron T Bar 3" Deep (Brewer Engineering for CPCO)
N 82 W 120.96 20" Ash
S 29 W 30.46 18" Oak
EAST 135.90 Iron T Bar
N 54 E 38.52 Tele Pole

PA 74

pg 23 (1875/564-565) Robert L. Mitchell 12-14-73
Found "T"-bar
Tele pole N 54 E 38.52
18" Oak S 29 W 30.46

PA 132 SURVEYS

Robert L. Mitchell 5-9-73
same as PA 74 pg 23 above

2271/157
Mark L. VanRaemdonck 9-10-86
Found T Iron
S 22 W 29.95 n/t in 24" Oak
N 30 W 198.25 n/t in PP
N 50 E 168.72 n/t in 12" Apple

2292/289
Jack N. Owens 4-2-87
Found T Iron
S 05 E 31.95 set n/t in E face 4" Spruce
N 05 E 27.84 set n/t in S face 6" Elm
S 30 W 44.51 fnd nail E face 10" tree
S 30 E 30.50 NW cor W'ly conc blk hdwl