

MAY 31 2000

SECTION

LAND CORNER RECORDATION CERTIFICATE

DEED LIBER 2522 PAGE

93

Filing Requirement of Act 74, Mich. P.A. 1970

(Remonumentation corner under P. A. 345, Michigan P.A. of 1990)

For corners in Genesee (County)

Located In: Forest Twp

Corner Code # H-3

- 1. Public Land Survey T 9N R 8E H-3
2. Property Controlling in Section S T R
3. Miscellaneous Property in Sec. S T R
4. Lot No. Recorded Plat
5. Private Claims

RECORDED REGISTERED JAN 6 8 42 AM '94 GENESSEE COUNTY FLINT MICHIGAN

Register of Deeds Stamp & File Number

FILED & RECORDED

Grid table with columns A-L and rows 1-13. Cell (3,4) contains a black dot.

I, Jack N. Owens, Prof. Surveyor, in a field survey on October 12 19 93, do hereby certify that under requirements of P.A. 74, Michigan P.A. of 1970, the corner points mentioned in lines 1 and 2 above were in conformance with regulations and rules therefor as required in the current manual of survey instructions of the United States Department of the Interior, Bureau of Land Management or by a decree of a Court of Law, and/or that the corner points mentioned in lines 3, 4 and 5 above were in conformance with the rules of the Michigan Board of Land Surveyors or by a Decree of a Court of Law, established, re-established, monumented, re-monumented, recovered, found as expressed below:

NOTE: Not more than 4 corners, all in the same town and range, may be recorded on this certificate.

A. Description of original monument and accessories and/or subsequent restoration:

- 1822, GLO-J. Fletcher, set post, no accessories
1882, GCSR-M. Middleton, cedar post, 1 accessory & shows msrmts. btwn corrs.
1935, GCRC & wit book, 1" sq. iron rod & 3 accessories
1973, REI sur. records, DTRowe, PS11192, fnd 5/8" rerod in mon box & 3 accessories
1974, Cert. Sur. L1897, P79, EJMccCombs, PS10696, fnd 1/2" rod in mon. box & 2 1973 accessories & 2 1935 accessories
1977, REI sur records, DTRowe, PS11192, fnd 5/8" rod in mon. box & 2 1935 accessories & 1 1973 accessories.

B. Description of corner evidence found and/or method applied in restoring or reestablishing corner:


- 1993 Gen. Co. Remon Program
Recovered 5/8" rod in mon. box & 6 accessories (C/L rd to S from 1973; p. pole to SE from 1972, 1974, & 1985;
15" Oak to North from 1935 & 1979; 15" Oak to SW from 1935 & 1973).
angle to N=180 deg 08' 38" (cf=180 deg 08' 45" in 1974; 180 deg 08' in 1935).
Dist. to G-3 = 2630.84' (39.861 ch.) EDM [cf = 2630.99' in 1974, 2632.30' in 1935, 39.855 ch (2360') in 1882, 39.925 ch (2635') GLO in 1822]
Dist I-3 = 2631.99' (39.871 ch) EDM, [cf = 2631.22' in 1935, 39.855' ch (2630') in 1882, 39.925 ch (2635') GLO in 1822]

Ratified by Gen. Co. Peer Group Dec. 21, 1993

C. Description of monument for corner and accessories established to perpetuate locating the position of the corner:

- Accessories:
south + 1.2' to C/L rd (Lake Rd.)
S30E, 59.21' fnd two-headed nail/disc w fc. p. pole (1974 acc.)
S30E, 59.05' fnd REI nail & tag #11192 NW fc. p. pole (1972 acc.)
S30E, 59.15' fnd pk NE fc. p. pole (1985 acc.)
N05E, 44.52' fnd pk SW fc. 15" Oak (1935 & 1979 acc.) 44.56' set spike/GCRemon tag in Sw fc.
S45W, 48.86' fnd pk in N fc. 15" Oak & 48.75 set spk/GCRemon tag SW fc.
N20E, 45.91' set spike/GCRemon tag in top center of 6" dia x 4.5" tall wood post

I set the standard Bernsten monument SS-A-5-BR-30 (3 1/4" d. brass cap stamped "Genesee County Remonumentation Corner, 20709, 1993" with 24" x 2 3/8" O.D. stainless steel tube) over rod in mon. box 1.2' N. of pvmt. C/L.

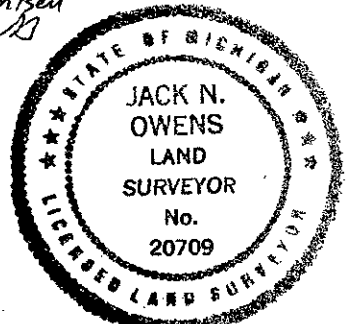

Signed by Jack N. Owens

Date 12-29-93

Surveyor's Michigan License No. 20709

