

MAY 31 2000

SECTION

LAND CORNER RECORDATION CERTIFICATE

DEED LIBER 2522 PAGE 95

Filing Requirement of Act 74, Mich. P.A. 1970

(Remonumentation corner under P.A. 345, Michigan P.A. of 1990)

For corners in

Genesee (County)

Located In: Forest Twp

Corner Code # J-3

- 1. Public Land Survey T 9N R 8E
2. Property Controlling in Section S T R
3. Miscellaneous Property in Sec. S T R

RECORDED REGISTERED JAN 6 8 43 AM '94 GENESSEE COUNTY FLINT MICHIGAN

Register of Deeds Stamp & File Number

FILED & RECORDED

- 4. Lot No. Recorded Plat
5. Private Claims

Grid table with columns A-M and rows 1-13. Cell (3,11) contains a black dot.

I, Jack N. Owens, Prof. Surveyor, in a field survey on October 12 19 93, do hereby certify that under requirements of P.A. 74, Michigan P.A. of 1970, the corner points mentioned in lines 1 and 2 above were in conformance with regulations and rules therefore as required in the current manual of survey instructions of the United States Department of the Interior, Bureau of Land Management or by a decree of a Court of Law and/or that the corner points mentioned in lines 3, 4 and 5 above were in conformance with the rules of the Michigan Board of Land Surveyors or by a Decree of a Court of Law; established, re-established, monumented, re-monumented, recovered, found as expressed below:

NOTE: Not more than 4 corners, all in the same town and range, may be recorded on this certificate.

A. Description of original monument and accessories and/or subsequent restoration:

1822, GLO, J. Fletcher, set post, no accessories
1882, GCSR - SNBedew, C.S. stone & pine root post, no accessories but shows msrmts btwn cors.
1930, GCRC & wit book, iron pin & 5 accessories
1969, REI sur. records DTRowe,, PS11192, center of cover of mon. box & 3 accessories
1974, Cert Sur. L1900, P893, JSFokens, PS21567, fnd "+" in top mon. box, & 3 accessories from 1969
1976, cert sur. L1951, P961, JABeck, PS21559, does not describe mon., & 2 accessories from 1969 & 1 from 1930

1979, LCRC L2034, P424, JSFokens, PS21567 fnd iron pin, & 5 accessories from 1930
1990, Cert. Sur. L2416, P9,, JNOWens PS20709, fnd rod in mon box, & 4 accessories
1992, Cert. Sur. L2469, P880, HNELrich, PS18986, fnd 5/8" iron in mon. box, & 3 accessories from 1990 & 1 new one.

B. Description of corner evidence found and/or method applied in restoring or reestablishing corner:

1993 Gen. Co. Remon Program
Recovered 1/2" rod in mon. box & 7 accessories (Cottonwood to SW from 1990; 2 nails in same 18" Ash to SW from 1969 & 1990; 2 nails in same 15" Ash stump to North from 1969 & 1990; 2 nails in same 16" twin Cottonwood to NW from 1990).
Dist to I-3=2637.10' [39.956 chs] EDM
(cf = 2641.15' [40.017 chs] in 1930, 2653.2' [40.20 chs] in 1882, 2640.00' [40.00 chs] in 1822 GLO)
Total mile constant = 5291.52' [80.174 ch]
EDM (cf = 5297.0' [80.258 chs] in 1930, 5304.4' [80.37 chs] in 1882, 5280.00' [80.00 chs] in 1822 GLO.
Angle to North = 179 deg 17'28" (cf = 179 deg 19' in 1930)


The corner position hasn't changed since 1882 & shows pattern by Co. Sur. & GCRC to perpetuate with stones & new monumentation after each road project. I accept the 1/2" rod in the mon. box as a faithful and careful perpetuation of the position of the original corner

Ratified by Gen Co. Peer Group Dec 21, 1993

C. Description of monument for corner and accessories established to perpetuate locating the position of the corner:

Accessories:
S50W, 82.18' fnd nail/flag in NW fc. 18" Cottonwood & 82.22' set spike/GCRemon tag in NW fc.
S70W, 87.53' fnd nail/flag in NNW fc. 18" Ash & 88.05' fnd nail/flag in NW fc & 87.80' set spike GCRemon tag in NW fc.
North, 27.78' fnd nail/flag in W fc 15" Ash-cut off (8' stump) & 27.29' fnd nail/flag in S. fc. & 28.00' set spike/GCRemon tag in W. fc.
N40W, 51.98' fnd nail/flag in NE fc 16" twin Cottonwood & 51.65' fnd nail/flag in SE fc & 51.99' set spike/GCRemon tag in NE fc.

I set the standard Bernsten monument SS-A-5-BR-30 (3 1/2" d. brass cap stamped "Genesee County Remonumentation Corner, 20709, 1993" with 24" x 2 3/8"

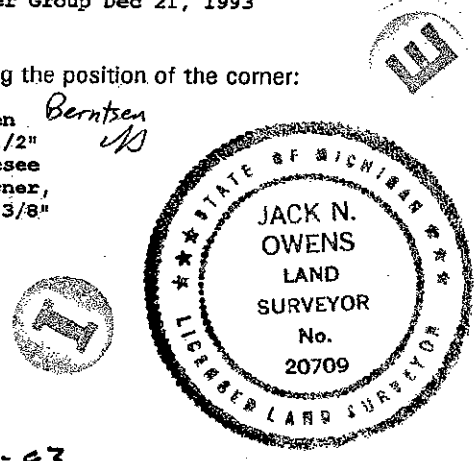

Signed by Jack N. Owens

Date 12-29-93

Surveyor's Michigan License No. 20709

Handwritten marks: 57, C, I