

**SURVEY & REMONUMENTATION**

MAY 31 2000

DEED LIBER 2561 PAGE 69

**1994 REMONUMENTATION PROGRAM  
LAND CORNER RECORDATION CERTIFICATE**

SECTION

Filing Requirement of Act 74, Mich. P.A. 1970

For corners in Forest Twp.

GENESEE (County)	Located In:	Corner Code #
1. Public Land Survey	T 09N R 08E	M-1
	T _____ R _____	_____
	T _____ R _____	_____
	T _____ R _____	_____
2. Property Controlling in Section	S _____ T _____ R _____	_____
	S _____ T _____ R _____	_____
3. Miscellaneous Property in Sec.	S _____ T _____ R _____	_____
	S _____ T _____ R _____	_____

RECORDED  
 REGISTER OF DEEDS  
 Dec 28 3 31 PM '94  
 GENESEE COUNTY  
 REGISTER OF DEEDS  
 Register of Deeds Stamp & File Number

4. Lot No. \_\_\_\_\_, Recorded Plat \_\_\_\_\_  
 5. Private Claims \_\_\_\_\_

	A	B	C	D	E	F	G	H	I	J	K	L	M
1													
2	6	5	4	3	2	1							
3													
4	7	8	9	10	11	12							
5													
6	18	17	16	15	14	13							
7													
8	19	20	21	22	23	24							
9													
10	30	29	28	27	26	25							
11													
12	31	32	33	34	35	36							
13													

I, JONATHAN M. FIELD, in a field survey on SEPTEMBER 29 19 94 do hereby certify that under requirements of P.A. 74, Michigan P.A. of 1970, the corner points mentioned in lines 1 and 2 above were in conformance with regulations and rules therefore as required in the current manual of survey instructions of the United States Department of the Interior, Bureau of Land Management or by a decree of a Court of Law and/or that the corner points mentioned in lines 3, 4 and 5 above were in conformance with the rules of the Michigan Board of Land Surveyors or by a Decree of a Court of Law; established, re-established, monumented, re-monumented, recovered, found as expressed below:

NOTE: Not more than 4 corners, all in the same town and range, may be recorded on this certificate.


- A. Description of original monument and accessories and/or subsequent restoration:
- 1821 GLO; WAMPLER, D.S.; SET POST; TAMARACK 12 S74 1/2E 19LKS., ASH 21 N80W 43LKS.
  - 1900 FELTON, TUSCOLA C.S.; SURVEY OF SEC.36, T10N-R8E; SET FROM B.T.'S IN 1879; CEDAR POST AND CROCKERY; NO WITS GIVEN, "STAKE STANDS ON EXTREME E. SIDE OF POINT EXTENDING INTO S. SIDE OF POWDER HORN LAKE"
  - 1993 ROWE ENG; FIELD, P.S.#37276; 1993 TUSCOLA CO. REMON; FND 1/2" PIPE ON-E. SIDE OF POINT ON S. SIDE OF POWDER HORN LAKE IN BOGGY AREA, MEASUREMENT W. TO K-13, T10N-R8E IS W/IN 3.5' OF 1900 CO. SURVEY DIST., NO EVIDENCE OF OCCUPIED LINE TO S., POWDER HORN LAKE TO N.; ACCEPTED FND PIPE - SET STANDARD TUSCOLA CO. REMON. MONUMENT AND WITNESS MONUMENT ON S. LINE OF T10N-R8E 130.00' W. OF M-13; SEE TUSCOLA CO. L.C.R.C. PG.82 MILLINGTON TWP. AND SECTION C. BELOW FOR WITNESSES
  - 1994 GRAVLIN LAND SURVEY; GRAVLIN, P.S.#23510; UNRECORDED SURVEY FOR LAPEER CO. BANK & TRUST JOB NO. 940109; FND IRON & CAP; W.130.00' WIT MON., S60W 45.30' 10" MAPLE, N. 38.16' SET 1/2" ROD AT W 1/4 COR. SEC.6 T9N-R9E
- B. Description of corner evidence found and/or method applied in restoring or reestablishing corner:
- 1994 ROWE ENG.; FIELD, P.S.#37276; FND BOTH TUSCOLA CO. MONUMENTS IN GOOD CONDITION AND ALL WITNESSES CITED IN 1993 TUSCOLA CO. L.C.R.C. PG.82 FOR MILLINGTON TWP.

ACCEPTED THE TUSCOLA CO. CORNER AS MONUMENTED AS BEING M-1 T9N-R8E

RATIFIED BY GEN. CO. PEER GROUP NOV. 9, 1994

Ratified by Peer Group in accordance with P.A. 345, 1990  
 Co. Rep. Carl Carlson  
 Date Nov 9, 1994

- C. Description of monument for corner and accessories established to perpetuate locating the position of the corner:
- M-1 SET STANDARD GENESEE CO. MONUMENT ON E. TWP. LINE AS REFERENCE TO CORNER M-1 (WITNESSES ARE TO REFERENCE MONUMENT NOT CORNER)
  - N34°E, 3.40' SET NAIL W/REMON TAG IN W. FACE TWIN 12" OAK
  - S20°E, 16.86' SET NAIL W/REMON TAG IN NE FACE 20" OAK
  - S35°W, 17.56' SET NAIL W/REMON TAG IN E. FACE 16" MAPLE
  - N75°W, 20.57' SET NAIL W/REMON TAG IN N. FACE 10" OAK
  - NORTH, 197.60' FND 5/8" ROD W/ TUSCOLA CO. REMON CAP AT CORNER M-1

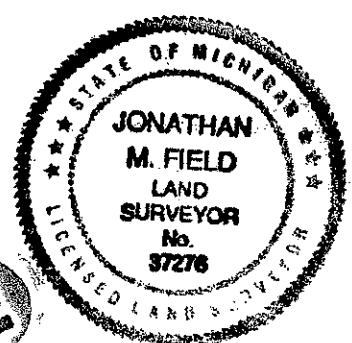

Signed by Jonathan M. Field  
 Surveyor's Michigan License No. 37276

Date 12-8-94



9.00  
 Filed & REC

73967

60