

MAY 31 2000

1994 REMONUMENTATION PROGRAM
LAND CORNER RECORDATION CERTIFICATE

DEED LIBER 2561 PAGE 70

SECTION

Filing Requirement of Act 74, Mich. P.A. 1970

For corners in Forest Twp.
GENESEE
(County)

Located in:

Corner Code #

- 1. Public Land Survey T 09N R 08E M-2
- T R
- T R
- T R
- 2. Property Controlling S T R
- in Section S T R
- 3. Miscellaneous S T R
- Property in Sec. S T R

- 4. Lot No. _____, Recorded Plat _____
- 5. Private Claims _____

I, JONATHAN M. FIELD, in a field survey on SEPTEMBER 29 19 94, do hereby certify that under requirements of P.A. 74, Michigan P.A. of 1970, the corner points mentioned in lines 1 and 2 above were in conformance with regulations and rules therefore as required in the current manual of survey instructions of the United States Department of the Interior, Bureau of Land Management, or by a decree of a Court of Law and/or that the corner points mentioned in lines 3, 4 and 5 above were in conformance with the rules of the Michigan Board of Land Surveyors or by a Decree of a Court of Law, established, re-established, monumented, re-monumented, recovered, found as expressed below:

NOTE: Not more than 4 corners, all in the same town and range, may be recorded on this certificate.


- A. Description of original monument and accessories and/or subsequent restoration:
 - 1821 GLO; WAMPLER; D.S.; NOT SET "1/4 S. COR. IN LAKE"; NO WITS GIVEN
 - 1882 S.R. BILLINGS; PLAT OF W.C. CUMINGS ADDITION TO OTTER LAKE; SHOWS SECTION & COUNTY LINE ROAD ALONG W. SIDE OF PLAT BUT DOES NOT SHOW CORNER
 - 1882 S.R. BILLINGS; PLAT OF JOHN B. WILSON'S ADDITION TO OTTER LAKE; SHOWS SECTION & COUNTY LINE ROAD ALONG E. SIDE OF PLAT BUT DOES NOT SHOW CORNER
 - 1979 PERLA STOUT ASSOC.; UNRECORDED SURVEY FOR TOM HACNEY JOB NO. 7930; SHOWS E. LINE OF SEC. 1 T9N-R8E BEING MONUMENTED FROM OLD RR GRADE N. TO S. SIDE OF LAKE; CORNER NOT SHOWN
 - 1989 FLINT SURVEYING; CARLSON, P.S.#9189; UNRECORDED SURVEY FOR LAKE & COUNTRY REALTY JOB NO. 10379; SHOWS E. LINE OF SEC.1 T9N-R8E BEING MONUMENTED AT S SIDE OF LAKE CORNER NOT SHOWN FND NO SUBSEQUENT RECORD OF CORNER

- B. Description of corner evidence found and/or method applied in restoring or reestablishing corner:
 - 1994 ROWE ENG. - FIELD, P.S.#37276; CORNER POSITION FALLS IN OTTER LAKE;
 - THIS POSITION NOT ESTABLISHED BY ORIGINAL GOVERNMENT SURVEY
 - RE-ESTABLISHED CORNER POSITION BY SINGLE PROPORTION BETWEEN M-3 T9N-R8E & M-1 T9N-R8E ON LINE FROM M-3 EXTENDED THROUGH FND 1/2" ROD W/CAP #9189 ON S'LY BANK OF OTTER LAKE
 - CORNER POSITION THUS ESTABLISHED YIELDS DISTANCE OF 2625.35' N. TO M-1 & S. TO M-3 WHICH IS CONSISTENT WITH OTHER 1/2 MILE DISTANCES MEASURED ALONG THIS RANGE LINE ALSO CORNER POSITION WOULD FALL ONLY 2'E. OF STRAIGHT LINE BETWEEN M-3 & M-1

RATIFIED BY GEN. CO. PEER GROUP NOV. 9, 1994

- C. Description of monument for corner and accessories established to perpetuate locating the position of the corner:
 - M-2 SET STANDARD GENESEE CO. MONUMENT OVER FND ROD W/CAP #9189 ON S. BANK OF OTTER LAKE AS REFERENCE TO CORNER POSITION WHICH IS 276.17' NORTH ALONG E. TOWNSHIP LINE
 - FOLLOWING WITNESSES ARE TO REFERENCE MONUMENT SET ON E. TOWNSHIP LINE - NOT TO CORNER)

- N35°E, 26.87' SET NAIL W/REMON TAG IN W. FACE 6" ASH
- S80°E, 63.33' SET NAIL W/REMON TAG IN S. FACE 24" POPLAR
- SOUTH, 45.65' SET NAIL W/REMON TAG IN W. FACE 22" ELM
- N60°W, 7.29' SET NAIL W/REMON TAG IN N. FACE 6" ELM
- NORTH, 30'+/- S. EDGE OF WATER (OTTER LAKE)

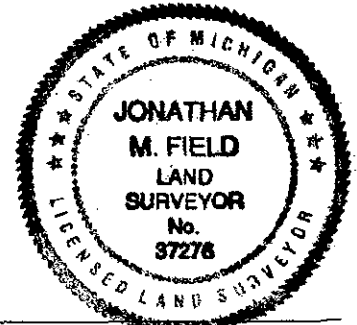

Signed by Jonathan M. Field

Date 12-8-94

Surveyor's Michigan License No. 37276

Ratified by Peer Group in accordance with P.A. 345, 1990

Co. Rep. Carl Carlson
Date Nov 9, 1994

73968

9.00
Filed + rec 6/

1	A	B	C	D	E	F	G	H	I	J	K	L	M
2	6	5	4	3	2	1							
3													
4	7	8	9	10	11	12							
5													
6	18	17	16	15	14	13							
7													
8	19	20	21	22	23	24							
9													
10	30	29	28	27	26	25							
11													
12	31	32	33	34	35	36							
13													

Register of Deeds Stamp & File Number

RECORDED
REGISTER OF DEEDS
DEC 28 3 31 PM '94
GENESEE COUNTY
REGISTER OF DEEDS