

APR 27 1995

1994 REMONUMENTATION PROGRAM LAND CORNER RECORDATION CERTIFICATE

Filing Requirement of Act 74, Mich. P.A. 1970

COMMISSION

For corners in Forest Twp.

GENESEE

(County)

Located in:

Corner Code #

1. Public Land Survey

T 09N R 08E

M-4

2. Property Controlling in Section

S T R

3. Miscellaneous Property In Sec.

S T R

4. Lot No. Recorded Plat

5. Private Claims

RECORDED FEB 1 10 17 AM '95 5505 Register of Deeds Stamp & File Number

Grid table with columns A-M and rows 1-13. Cell (4,12) contains a dot.

I, JONATHAN M. FIELD, in a field survey on SEPTEMBER 29 19 94 do hereby certify that under requirements of P.A. 74, Michigan P.A. of 1970, the corner points mentioned in lines 1 and 2 above were in conformance with regulations and rules therefore as required in the current manual of survey instructions of the United States Department of the Interior, Bureau of Land Management or by a decree of a Court of Law and/or that the corner points mentioned in lines 3, 4 and 5 above were in conformance with the rules of the Michigan Board of Land Surveyors or by a Decree of a Court of Law; established, re-established, monumented, re-monumented, recovered, found as expressed below:

NOTE: Not more than 4 corners, all in the same town and range, may be recorded on this certificate.

A. Description of original monument and accessories and/or subsequent restoration:

1821 GLO; WAMPLER, D.S.; SET 1/2 MILE POST; MAPLE 6 S1E 18LKS., TAMARACK 6 N8OW 16LKS. 1883 BEDEN, C.S.; SURVEY OF SEC.12, T9N-R8E; STONE; WEST 50LKS. PINE ROOT SET ??? GENEESEE CO. RD. COMM.; CORNER WITNESS BOOK; 2 STONE & BRICK; SE 53.0' SW COR. HEADWALL, SW 121.35' 18" ELM

B. Description of corner evidence found and/or method applied in restoring or reestablishing corner:

1994 ROWE ENG.; FIELD, P.S.#37276; FND NO EVIDENCE OF MONUMENT AT CORNER; FND NO EVIDENCE OF PREVIOUS WITNESSES CITED IN SECTION A. ABOVE


RE-ESTABLISHED CORNER POSITION BY SINGLE PROPORTION BETWEEN M-3 T9N-R8E & M-5 T9N-R8E ON LINE EXTENDED FROM M-5 THRU APPARENT A-5 T9N-R9E (FND 1" BAR W/ PREVIOUS WITNESSES BY C.H.M.P. & FLINT SURVEYING CO.) POSITION THUS ESTABLISHED FALLS ON C/L OF ASPH. ROAD N-S & 32.0' E. OF OLD 8" WOOD ANCHOR POST (ALSO TREE LINE 300'+/- TO W.)

ACCEPTED AS A CAREFUL AND FAITHFUL REESTABLISHMENT OF THE ORIGINAL CORNER POSITION

RATIFIED BY GEN. CO. PEER GROUP NOV. 9, 1994

C. Description of monument for corner and accessories established to perpetuate locating the position of the corner:

H-13 SET STANDARD GENESEE CO. MONUMENT IN MON. BOX SOUTH, 58.24' FND. 1" ROD WEST, 31.82' SET P-K NAIL W/REMON TAG IN S. FACE OLD WOOD ANCHOR POST N85°E, 34.27' SET P-K NAIL W/REMON TAG IN N. FACE GUY POLE S50°W, 52.23' SET P-K NAIL W/REMON TAG IN SE FACE P. POLE

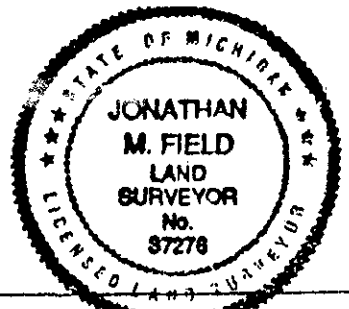

Signed by Jonathan M. Field

Date 1-13-95

Surveyor's Michigan License No. 37276

Ratified by Peer Group in accordance with P.A. 345, 1990

Co. Rep. [Signature] Date 11-9-94