

SURVEY & REMONUMENTATION

APR 27 1995

DEED LIBER 2564 PAGE 560
1994 REMONUMENTATION PROGRAM
LAND CORNER RECORDATION CERTIFICATE
 Filing Requirement of Act 74, Mich. P.A. 1970

GENESEE COUNTY
 REGISTERED

FEB 1 10 17 AM '95

RECORDED

RECORDED

For commission
GENESEE
 (County)

Located In:

Corner Code #

- | | | |
|------------------------------------|-------------|-----|
| 1. Public Land Survey | T 09N R 08E | M-5 |
| | T R | |
| | T R | |
| | T R | |
| | T R | |
| 2. Property Controlling in Section | S T R | |
| | S T R | |
| 3. Miscellaneous Property in Sec. | S T R | |
| | S T R | |

5504
 Register of Deeds Stamp & File Number

4. Lot No. _____, Recorded Plat _____
 5. Private Claims _____

	A	B	C	D	E	F	G	H	I	J	K	L	M
2	6	5	4	3	2	1							
3													
4	7	8	9	10	11	12							
5													
6	18	17	16	15	14	13							
7													
8	19	20	21	22	23	24							
9													
10	30	29	28	27	26	25							
11													
12	31	32	33	34	35	36							
13													

I, JONATHAN M. FIELD, in a field survey on SEPTEMBER 29 19 94, do hereby certify that under requirements of P.A. 74, Michigan P.A. of 1970, the corner points mentioned in lines 1 and 2 above were in conformance with regulations and rules therefore as required in the current manual of survey instructions of the United States Department of the Interior, Bureau of Land Management or by a decree of a Court of Law and/or that the corner points mentioned in lines 3, 4 and 5 above were in conformance with the rules of the Michigan Board of Land Surveyors or by a Decree of a Court of Law; established, re-established, monumented, re-monumented, recovered, found as expressed below:

NOTE: Not more than 4 corners, all in the same town and range, may be recorded on this certificate.

A. Description of original monument and accessories and/or subsequent restoration:


- 1821 GLO; WAMPLER, D.S.; SET POST; BEECH 10 S8E 22LKS., BEECH 15 N37E 13LKS.
- 1883 BEDEN, C.S.; SURVEY OF SEC.12, T9N-R8E; PINE ROOT POST; N88E 49LKS. 40" PINE STUMP
- 1883 BEDEN, C.S.; SURVEY OF SEC.13, T9N-R8E; STONE; NO WITS GIVEN
- 1936 GENESEE CO. RD. COMM.; FIELD BOOK NOTES FOR FARRAND RD.; SPIKE @ APPROX. CO. LINE ROAD; STA. 106+44.65; NO OTHER INFO REGARDING ACTUAL CORNER
- 1982 ROWE ENG.; FOKENS, P.S.#21567; SURVEY NOTE FOR OTTER LAKE K.O.A. CAMPGROUND; END 3/4" ROD; NO WITS GIVEN

B. Description of corner evidence found and/or method applied in restoring or reestablishing corner:

- 1994 ROWE ENG.; FIELD, P.S.#37276; END 3/4" ROD 0.5' W. OF C/L ASPH. ROAD N-S & 10' S. OF C/L GRAVEL ROAD TO W. END NO EVIDENCE OF PREVIOUS WITNESSES CITED IN SECTION A. ABOVE
- ACCEPTED 3/4" ROD AS A CAREFUL AND FAITHFUL PERPETUATION OF THE ORIGINAL CORNER POSITION
- RATIFIED BY GEN. CO. PEER GROUP NOV. 9, 1994

C. Description of monument for corner and accessories established to perpetuate locating the position of the corner:

- SET STANDARD GENESEE CO. MONUMENT OVER END 3/4" ROD IN MON. BOX
- M-5 SOUTH, 95.45' END. R.R. SPIKE IN ASPH. ROAD
- S20°E, 84.97' SET P-K NAIL W/REMON TAG IN SW FACE OLD WOOD CORNER FENCE POST
- S75°W, 59.71' SET P-K NAIL W/REMON TAG IN NW FACE GUY POLE
- N10°E, 93.19' SET P-K NAIL W/REMON TAG IN W. FACE GUY POLE

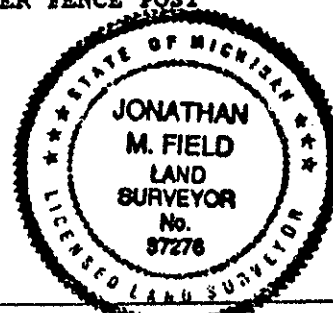

Signed by Jonathan M. Field

Date 1-13-95

Surveyor's Michigan License No. 37276

Ratified by Peer Group in accordance with P.A. 345, 1990

Co. Rep. Carl Carlson

Date 11-9-94