

SURVEY & REMONUMENTATION

MAY 31 2000

DEED LIBER 2561 PAGE 72

**1994 REMONUMENTATION PROGRAM
LAND CORNER RECORDATION CERTIFICATE**

Filing Requirement of Act 74, Mich. P.A. 1970

SECTION

For corners in Forest Twp.

GENESEE

(County)

Located In:

Corner Code #

1. Public Land Survey	T 09N R 08E	M-6
	T R	
	T R	
	T R	
2. Property Controlling in Section	S T R	
	S T R	
3. Miscellaneous Property in Sec.	S T R	
	S T R	

GENESEE COUNTY REGISTER OF DEEDS
 DEC 28 3 32 PM '94
 REGISTER OF DEEDS
 JONATHAN M. FIELD

Register of Deeds Stamp & File Number

4. Lot No. _____, Recorded Plat _____
 5. Private Claims _____

	A	B	C	D	E	F	G	H	I	J	K	L	M
1													
2	6	5	4	3	2	1							
3													
4	7	8	9	10	11	12							
5													
6	18	17	16	15	14	13							
7													
8	19	20	21	22	23	24							
9													
10	30	29	28	27	26	25							
11													
12	31	32	33	34	35	36							
13													

I, JONATHAN M. FIELD, in a field survey on SEPTEMBER 29 19 94, do hereby certify that under requirements of P.A. 74, Michigan P.A. of 1970, the corner points mentioned in lines 1 and 2 above were in conformance with regulations and rules therefore as required in the current manual of survey instructions of the United States Department of the Interior, Bureau of Land Management or by a decree of a Court of Law and/or that the corner points mentioned in lines 3, 4 and 5 above were in conformance with the rules of the Michigan Board of Land Surveyors or by a Decree of a Court of Law; established, re-established, monumented, re-monumented, recovered, found as expressed below:

NOTE: Not more than 4 corners, all in the same town and range, may be recorded on this certificate.

A. Description of original monument and accessories and/or subsequent restoration:

- 1821 GLO; WAMPLER, D.S.; SET 1/2 MILE POST 1.00 E. OF SMALL LAKE; MAPLE 5 S34W 9LKS., BEECH 11 S53E 21 LKS.
- 1883 BEDEN, C.S.; SURVEY OF SEC. 13, T9N-R8E; OAK POST; WEST 50LKS STAKE, N69W 62LKS. 22" PINE STUMP
- 1963 ROWE ENG.; UNRECORDED SURVEY FOR ANTHONY LEKI JOB NO. F-0282; CORNER SHOWN BUT NO OBJECT STATED; NO WITS GIVEN
- ???? GENESEE CO. RD. COMM.; CORNER WITNESS BOOK; 3/4" PIPE; S. 130.69' NW COR. SEC. 19 T9N-R9E S35W 51.55' BOXELDER, N80W 30.95' BOXELDER, N10W 64.94' ASPEN

B. Description of corner evidence found and/or method applied in restoring or reestablishing corner:

- 1994 ROWE ENG.; FIELD, P.S.#37276; END 3/4" PIPE IN MON. BOX 0.5' W. OF C/L ASPH. ROAD N-S & 66' +/- E. OF E. EDGE OF SISTER LAKE APPARENT A-7 T9N-R9E (END 3/4" ROD IN MON. BOX) MEASURES 130.33' VS. 130.69' PER GENESEE CO. RD COMM. CITED IN SECTION A. ABOVE

ACCEPTED 3/4" PIPE AS A CAREFUL AND FAITHFUL PERPETUATION OF THE ORIGINAL CORNER POSITION


RATIFIED BY GEN. CO. PEER GROUP NOV. 9, 1994

Ratified by Peer Group in accordance with P.A. 345, 1990

Co. Rep. Carl Carlson
 Date Nov 9, 1994

C. Description of monument for corner and accessories established to perpetuate locating the position of the corner:

- M-6 SET STANDARD GENESEE CO. MONUMENT OVER END 3/4" PIPE IN MON. BOX
- N35°E, 30.26' SET 1/2" ROD W/CAP #37276 IN ROAD SHOULDER
- WEST, 58.83' SET P-K NAIL W/REMON TAG IN N. FACE P. POLE
- S50°E, 39.43' SET P-K NAIL W/REMON TAG IN NE FACE P. POLE
- S25°W, 67.59' SET P-K NAIL W/REMON TAG IN TOP OF N'LY GATE POST

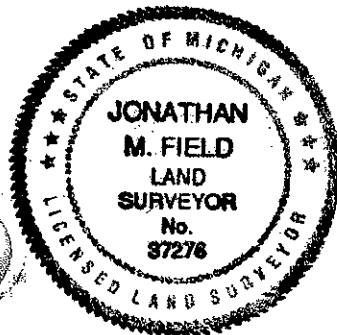

Signed by Jonathan M. Field
 Surveyor's Michigan License No. 37276

Date 12-8-94

63

\$9.00
 Filed & REC

73970