

SURVEY & REMONUMENTATION

MAY 31 2000

SECTION

**1994 REMONUMENTATION PROGRAM
LAND CORNER RECORDATION CERTIFICATE
Filing Requirement of Act 74, Mich. P.A. 1970**

DEED LIBER 2561 PAGE 73

RECORDED
REGISTER OF DEEDS
Dec 28 9 52 PM '94
GENESEE COUNTY REGISTER OF DEEDS

For corners in Forest Twp.

GENESEE (County)	Located In:	Corner Code #
1. Public Land Survey	T 09N R 08E	M-7
	T R	
	T R	
	T R	
2. Property Controlling in Section	S T R	
	S T R	
3. Miscellaneous Property in Sec.	S T R	
	S T R	

Register of Deeds Stamp & File Number

4. Lot No. _____, Recorded Plat _____
5. Private Claims _____

	A	B	C	D	E	F	G	H	I	J	K	L	M
1													
2	6	5	4	3	2	1							
3													
4	7	8	9	10	11	12							
5													
6	18	17	16	15	14	13							
7													
8	19	20	21	22	23	24							
9													
10	30	29	28	27	26	25							
11													
12	31	32	33	34	35	36							
13													

I, JONATHAN M. FIELD, in a field survey on SEPTEMBER 29 19 94, do hereby certify that under requirements of P.A. 74, Michigan P.A. of 1970, the corner points mentioned in lines 1 and 2 above were in conformance with regulations and rules therefore as required in the current manual of survey instructions of the United States Department of the Interior, Bureau of Land Management or by a decree of a Court of Law and/or that the corner points mentioned in lines 3, 4 and 5 above were in conformance with the rules of the Michigan Board of Land Surveyors or by a Decree of a Court of Law; established, re-established, monumented, re-monumented, recovered, found as expressed below:

NOTE: Not more than 4 corners, all in the same town and range, may be recorded on this certificate.


A. Description of original monument and accessories and/or subsequent restoration:
1821 GLO; WAMPLER, D.S.; SET POST; ELM 10 S23W 18LKS., PINE 8 N9E 27LKS.
1883 BEDEN, C.S.; SURVEY OF SEC. 13, T9N-R8E; PINE ROOT POST; WEST 50LKS. PINE ROOT POST SET
???? GENESEE CO. RD. COMM.; CORNER WITNESS BOOK; FND STONE & BRICK; NE 129.6' 8" OAK, SE 42.0
18" ELM, W. 21.8' X-ARM SIGN

B. Description of corner evidence found and/or method applied in restoring or reestablishing corner:
1994 ROWE ENG.; FIELD, P.S.#37276; FND 3/4" ROD IN MON. BOX 0.5' E. OF C/L ASPH. ROAD N-S & ON LINE WITH CLEARED OVERHEAD POWER LINE TO. FND NO EVIDENCE OF PREVIOUS WITNESSES
ACCEPTED 3/4" ROD AS A CAREFUL AND FAITHFUL PERPETUATION OF THE ORIGINAL CORNER POSITION
RATIFIED BY GEN. CO. PEER GROUP NOV. 9, 1994

Ratified by Peer Group
accordance with P.A. 345, 1994

Co. Rep. Carl Fisher
Date Nov 9, 1994

C. Description of monument for corner and accessories established to perpetuate locating the position of the corner:
M-7 SET STANDARD GENESEE CO. MONUMENT OVER FND 3/4" ROD IN MON. BOX
WEST, 33.22' FND 1/2" ROD
WEST, 51.45' FND NAIL IN S. FACE P. POLE
S45°E, 34.61' SET 1/2" ROD W/CAP #37276 IN ROAD SHOULDER
N45°E, 33.76' SET 1/2" ROD W/CAP #37276 IN ROAD SHOULDER

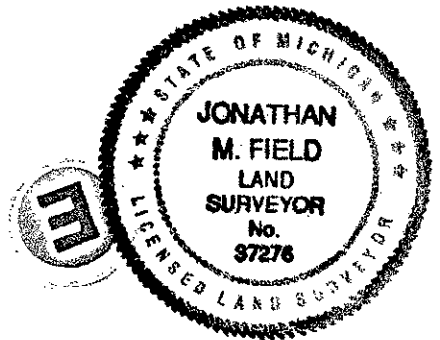

Signed by Jonathan M. Field Date 12-8-94
Surveyor's Michigan License No. 37276

64

\$ 9.00
Filed + REC

73971