

MAY 31 2000

1994 REMONUMENTATION PROGRAM LAND CORNER RECORDATION CERTIFICATE

Filing Requirement of Act 74, Mich. P.A. 1970

SECTION

For corners in Forest Twp.

Table with columns: GENESEE (County), Located In: (T 09N R 08E), Corner Code # (M-8). Rows include Public Land Survey, Property Controlling in Section, and Miscellaneous Property in Sec.

Register of Deeds Stamp & File Number. Includes vertical stamp: GENESEE COUNTY REGISTER OF DEEDS, DEC 28 3 32 PM 1994, and handwritten file number 73972.

4. Lot No. Recorded Plat
5. Private Claims

Grid table with columns A-M and rows 1-13. Contains numbers 1-36 in a grid pattern.

I, JONATHAN M. FIELD, in a field survey on SEPTEMBER 29 19 94 do hereby certify that under requirements of P.A. 74, Michigan P.A. of 1970, the corner points mentioned in lines 1 and 2 above were in conformance with regulations and rules therefore as required in the current manual of survey instructions of the United States Department of the Interior, Bureau of Land Management or by a decree of a Court of Law and/or that the corner points mentioned in lines 3, 4 and 5 above were in conformance with the rules of the Michigan Board of Land Surveyors or by a Decree of a Court of Law, established, re-established, monumented, re-monumented, recovered, found as expressed below:

NOTE: Not more than 4 corners, all in the same town and range, may be recorded on this certificate.

A. Description of original monument and accessories and/or subsequent restoration:

- 1821 GLO; WAMPLER, D.S.; SET 1/2 MILE POST; ELM 20 N77W 18LKS., SUGAR S48 1/2E 37LKS.
1934 GENESEE CO. RD. COMM.; FIELD BOOK NOTES FOR CRAWFORD RD.; STA. 53+87.30 "TRANSIT POINT"; NO OBJECT STATED; NO WITS GIVEN
???? GENESEE CO. RD. COMM.; CORNER WITNESS BOOK; STONE & BRICK; SE 110.8' 8" ELM, SW 34.7' STEEL A. POST, W. 115.8' 15" ELM, NW 37.0' CO. RD. SIGN, NNW 87.0' 10" OAK
???? GENESEE CO. RD. COMM.; CORNER WITNESS BOOK; 3/4" PIPE; N70E 22.68' FE POST, S55W 34.52' STEEL FE POST, N65W 61.03' FE POST, N18W 85.89' HICKORY
1975 HENDERSON-BATES; ELRICH, P.S.#18986; SURVEY L.1933, PG.791; FND 3/4" ROD; N85E 25.6' DEAD END SIGN, S45W 38.07' 18" CMP, N45W 39.90' 18" CMP
1975 ELRICH, P.S.#18986; L.C.R.C. L.1933, PG.797; FND 3/4" ROD; SAME WITS AS 1975 SURVEY
1979 DUNTON LAND SURVEYING; DUNTON, P.S.#23503; LAPEER CO. SURVEY L.5, PGS.514-515; FND 5/8" ROD IN MON. BOX; SOUTH 201'+/- FENCE LINE EAST, S45W 64.58' P-K NAIL IN P. POLE, N45W 47.72' P-K NAIL IN CORNER POST

B. Description of corner evidence found and/or method applied in restoring or reestablishing corner:

1994 ROWE ENG. - FIELD, P.S.#37276; FND 3/4" ROD IN MON. BOX 0.5' E. OF C/L ASPH. RD. N-S & C/L OF GRAVEL ROAD TO W. FND INDICATION OF BURIED 18" CMP TO W. 1975 WITS BY HENDERSON-BATES CHECK WITH APPROXIMATE ENDS OF BURIED CMP ALSO RECOVERED 2 PREVIOUS WITNESSES INDICATING FND ROD IS IN SAME POSITION AS 1979 DUNTON, ROD CITED ABOVE


ACCEPTED 3/4" ROD AS A CAREFUL AND FAITHFUL PERPETUATION OF THE ORIGINAL CORNER POSITION

RATIFIED BY GEN. CO. PEER GROUP NOV. 9, 1994

Handled by Peer Group accordance with P.A. 345, 1994
Co. Rep. [Signature]
Date [Signature]

C. Description of monument for corner and accessories established to perpetuate locating the position of the corner:

- M-8 SET STANDARD GENESEE CO. MONUMENT OVER FND 3/4" ROD IN MON. BOX
S85°E, 24.23' N. EDGE OF N. SIGN POST
S80°E, 24.88' S. EDGE OF S. SIGN POST
N45°W, 40.77' SW COR. OF ROAD SIGN POST
N80°E, 34.19' FND NAIL W/TAG IN S. FACE TRIPLE 6" ELM
S80°E, 31.72' FND NAIL W/FLAG. IN SW FACE 8" ELM
S45°W, 42.37' FND NAIL W/FLAG. IN N. FACE FENCE CORNER POST
S45°W, 64.55' FND P-K NAIL IN N. FACE P. POLE
N50°W, 54.40' FND NAIL W/ MSHD TAG IN SW FACE FENCE POST (LEANS W'LY)
N45°W, 48.50' FND P-K NAIL IN SW FACE FENCE CORNER POST (LEANS NW'LY)
N40°W, 52.28' FND P-K NAIL IN E. FACE FENCE POST (LEANS N'LY)

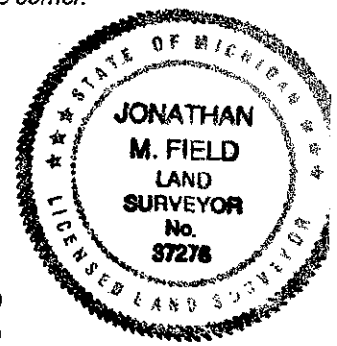

Signed by Jonathan M. Field Date 12-8-94
Surveyor's Michigan License No. 37276

73972 [E]

65 \$9.00 Filed + REC