

MAY 31 2000

1994 REMONUMENTATION PROGRAM LAND CORNER RECORDATION CERTIFICATE

DEED LIBER 2561 PAGE 75

SECTION

Filing Requirement of Act 74, Mich. P.A. 1970

For corners in Forest Twp.

Table with columns: GENESEE (County), Located In:, Corner Code #. Rows include Public Land Survey, Property Controlling in Section, Miscellaneous Property in Sec.

REGISTER OF DEEDS, REGISTER OF DEEDS, Register of Deeds Stamp & File Number

4. Lot No. Recorded Plat
5. Private Claims

Grid table with columns A-M and rows 1-13

I, JONATHAN M. FIELD, in a field survey on SEPTEMBER 29 19 94 do hereby certify that under requirements of P.A. 74, Michigan P.A. of 1970, the corner points mentioned in lines 1 and 2 above were in conformance with regulations and rules therefore as required in the current manual of survey instructions of the United States Department of the Interior, Bureau of Land Management or by a decree of a Court of Law and/or that the corner points mentioned in lines 3, 4 and 5 above were in conformance with the rules of the Michigan Board of Land Surveyors or by a Decree of a Court of Law; established, re-established, monumented, re-monumented, recovered, found as expressed below:

NOTE: Not more than 4 corners, all in the same town and range, may be recorded on this certificate.

- A. Description of original monument and accessories and/or subsequent restoration: 1821 GLO; WAMPLER, D.S.; SET POST; PINE 36 N68W 26LKS., MAPLE 13 N47W 23 LKS. 1921 GENESEE CO. RD. COMM.; CORNER WITNESS BOOK & FIELD BOOK NOTES FOR WILSON RD. TO CO.LINE; STONE; SW 35.4' A. POST, NW 68.2' 12" MAPLE, NW 64.5' 12" MAPLE, NW 36.1' PIPE A. POST 1946 GENESEE CO. RD. COMM.; FIELD BOOK NOTE FOR WILSON ROAD; 3/4" PIN; SW 45.22' BRASS PIN IN RD SIGN, WNW 94.80' 24" MAPLE, NW 68.20' 24" MAPLE, NNW 64.55' 24" MAPLE 1973 MITCHELL, P.S.#6936; L.C.R.C. L.1875, PGS.560-561; FND MONUMENT BOX; S30E 71.15' BELL UNDERGROUND CABLE BOX, S40W 83.22' P.POLE, N45W 64.25' 29" MAPLE 1975 HENDERSON-BATES; ELRICH, P.S.#18986; SURVEY L.1933, PG.791; FND 3/4" ROD; S35W 52.10' R/W MARKER, S45W 44.81' R/W MARKER, N70W 121.61' 24" STUMP, N30W 69.22' FENCE CORNER 1975 ELRICH, P.S.#18986; L.C.R.C. L.1933, PG.797; FND 3/4" ROD; SAME WITS AS 1975 SURVEY 1976 KAY ENG.; KAY, P.S.#14096; SURVEY L.1958, PG.650-651; FND 3/4" ROD; SAME WITS AS 1975 HENDERSON-BATES SURVEY ABOVE 1986-1993 GRAVLIN, P.S.#23510; SEVERAL LAPEER CO. SURVEYS SHOW 238' FROM A-10 T9N-R9E SOUTH TO M-9 T9N-R8E; NO OBJECT STATED; NO WITS GIVEN 1993 GRAVLIN LAND SURVEY, INC; GRAVLIN, P.S.#23510; LAPEER CO. SURVEY L.9, PG.1000; FND 3/4" IRON; SOUTH 237.75' TO A-10 T9N-R9E


- B. Description of corner evidence found and/or method applied in restoring or reestablishing corner: 1994 ROWE ENG. - FIELD, P.S.#37276; FND 3/4" ROD IN MON. BOX AT C/L - C/L ASPH. ROADS N-S-W RECOVERED 4 PREVIOUS WITNESSES INDICATING THAT FND ROD IS IN SAME POSITION AS 1973 LCRC AND LATER SURVEYS CITED IN SECTION A. ABOVE MEASURED DISTANCE TO APPARENT A-10 T9N-R9E IS 237.83' VS. 238' & 237.75' BY GRAVLIN SURVEYS CITED ABOVE

ACCEPTED 3/4" ROD AS A CAREFUL AND FAITHFUL PERPETUATION OF THE ORIGINAL CORNER POSITION RATIFIED BY GEN. CO. PEER GROUP NOV. 9, 1994

- C. Description of monument for corner and accessories established to perpetuate locating the position of the corner: M-9 SET STANDARD GENESEE CO. MONUMENT OVER FND 3/4" ROD IN MON. BOX. S35°W, 52.03' FND CHIS. + ON TOP OF CONC. PROJECT MARKER POST S45°W, 44.66' FND CHIS. + ON TOP OF CONC. PROJECT MARKER POST N30°W, 69.30' SE FACE OF STEEL FENCE CORNER POST S40°W, 83.76' FND NAIL W/ MSHD TAG IN SE FACE P.POLE S40°W, 83.83' FND NAIL W/TAG IN SE FACE P.POLE

Ratified by Peer Group in accordance with P.A. 345, 1990 Co. Rep. Carl Carlson Date Nov-9, 1994

Signed by Jonathan M Field Surveyor's Michigan License No. 37276

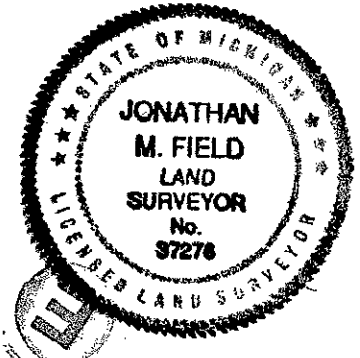

\$9.00 Filed + REC 73973 666