

MAY 31 2000

1994 REMONUMENTATION PROGRAM LAND CORNER RECORDATION CERTIFICATE

Filing Requirement of Act 74, Mich. P.A. 1970

SECTION

For corners in Forest Twp. GENESEE (County)

Located In:

Corner Code #

- 1. Public Land Survey T 09N R 08E M-10
2. Property Controlling in Section S T R
3. Miscellaneous Property in Sec. S T R

RECORDED REGISTER OF DEEDS DEC 28 3 32 PM '94 GENESEE COUNTY REGISTER OF DEEDS

Register of Deeds Stamp & File Number

- 4. Lot No. Recorded Plat
5. Private Claims

Grid table with columns A-L and rows 1-13. Contains numbers 1-36 in a grid pattern.

I, JONATHAN M. FIELD, in a field survey on SEPTEMBER 29 19 94 do hereby certify that under requirements of P.A. 74, Michigan P.A. of 1970, the corner points mentioned in lines 1 and 2 above were in conformance with regulations and rules therefore as required in the current manual of survey instructions of the United States Department of the Interior, Bureau of Land Management or by a decree of a Court of Law and/or that the corner points mentioned in lines 3, 4 and 5 above were in conformance with the rules of the Michigan Board of Land Surveyors or by a Decree of a Court of Law; established, re-established, monumented, re-monumented, recovered, found as expressed below:

NOTE: Not more than 4 corners, all in the same town and range, may be recorded on this certificate.

- A. Description of original monument and accessories and/or subsequent restoration: 1821 GLO; WAMPLER, D.S.; SET POST; W.O. 26 SOUTH 16LKS., SUGAR 8 N24W 30LKS. ??? GENESEE CO. RD. COMM.; CORNER WITNESS BOOK; 3 STONES; E. 24.7' A. POST, SW 142.5' TWIN ELMs, NW 135.0' 18" ELM
1920 GENESEE CO. RD. COMM.; FIELD BOOK NOTES FOR CO. LINE RD.; E1/4 COR. SEC.25 269.25' NORTH OF W1/4 COR. SEC.30 T9N-R9E BY STATIONING; NO OBJECT STATED, NO WITS GIVEN
1972 HENDERSON-BATES; ELRICH, P.S.#18986; LAPEER CO. SURVEY L.1, PG.331; FND P-K NAIL; S80W 67.96' NE COR. OF HOUSE, WEST 83.21' P.POLE
1973 MITCHELL, P.S.#6936; L.C.R.C. L.1849, PGS.326-327; FND TAG; S75W 83.2' COR. BLDG., WEST 67.9' P.POLE, N15W 95.6' STUMP
1976 KAY ENG.; KAY, P.S.#14096; SURVEY L.1958, PGS. 650-651; FND P-K NAIL; S80W 67.96' NE COR HOUSE, WEST 83.21' P.POLE

- B. Description of corner evidence found and/or method applied in restoring or reestablishing corner: 1994 ROWE ENG.; FIELD, P.S.#37276; FND NO EVIDENCE OF MONUMENT AT CORNER. 1972 AND 1976 WITNESSES TO HOUSE & P.POLE ABOVE ARE PROBABLY SWITCHED AS EVIDENCED BY 1973 MITCHELL WITS AND EXISTING HOUSE & POLE RE-ESTABLISHED CORNER POSITION BY RETRACEMENT OF 1976 KAY ENG. SURVEY, (HELD LINE FROM M-9 THRU POINT 33'E. OF KAY'S R.O.W. AND INTERSECTED WITH LINE AT KAY'S RECORDED ANGLE THRU FND ROD W/CAP #14096 33'W. OF CORNER)

ACCEPTED AS A CAREFUL AND FAITHFUL REESTABLISHMENT OF THE ORIGINAL CORNER POSITION


RATIFIED BY GEN. CO. PEER GROUP DEC. 7, 1994

- C. Description of monument for corner and accessories established to perpetuate locating the position of the corner:

M-10 SET STANDARD GENESEE CO. MONUMENT IN MON. BOX WEST, 67.93' SET P-K NAIL W/REMON TAG IN S. FACE P.POLE S85°W, 83.20' NE COR. OF BRICK HOUSE #10249 N45°E, 25.57' SET 1/2" ROD W/CAP #37276 IN ROAD SHOULDER S45°E, 24.67' SET 1/2" ROD W/CAP #37276 IN ROAD SHOULDER

Ratified by Peer Group in accordance with P.A. 345, 1990

Co. Rep. [Signature] Date Dec 7, 1994

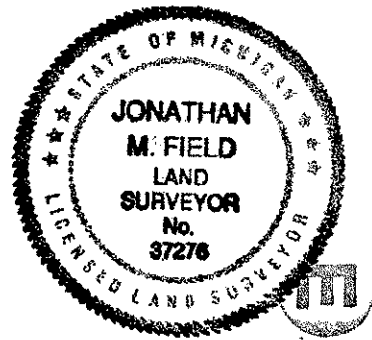

Signed by Jonathan M. Field

Date 12-8-94

Surveyor's Michigan License No. 37276

67 \$9.00 Filed & Rec

73974