

MAY 31 2000

1994 REMONUMENTATION PROGRAM LAND CORNER RECORDATION CERTIFICATE

DEED LIBER 2561 PAGE 77

SECTION

Filing Requirement of Act 74, Mich. P.A. 1970

For corners in Forest Twp.

Table with columns: GENESEE (County), Located In:, Corner Code #. Rows include Public Land Survey, Property Controlling in Section, Miscellaneous Property in Sec.

REGISTERED REGISTER OF DEEDS REGISTER OF DEEDS Register of Deeds Stamp & File Number

4. Lot No. Recorded Plat 5. Private Claims

I, JONATHAN M. FIELD, in a field survey on SEPTEMBER 29 19 94 do hereby certify that under requirements of P.A. 74, Michigan P.A. of 1970, the corner points mentioned in lines 1 and 2 above were in conformance with regulations and rules therefore as required in the current manual of survey instructions of the United States Department of the Interior, Bureau of Land Management or by a decree of a Court of Law and/or that the corner points mentioned in lines 3, 4 and 5 above were in conformance with the rules of the Michigan Board of Land Surveyors or by a Decree of a Court of Law; established, re-established, monumented, re-monumented, recovered, found as expressed below:

Grid table with columns A-M and rows 1-13. Contains numbers 1-36.


NOTE: Not more than 4 corners, all in the same town and range, may be recorded on this certificate.

- A. Description of original monument and accessories and/or subsequent restoration: 1821 GLO; WAMPLER, D.S.; SET POST; BEECH 12 N65W 21LKS., BEECH 6 S13E 20LKS. 1884 BEDEN, C.S.; SURVEY OF SEC.36, T9N-R8E; STONE; NO WITS GIVEN 1924 GENESEE CO. RD. COMM.; FIELD BOOK NOTES FOR DODGE RD. "DIDN'T FIND THIS CORNER. SPLIT FENCES LEFT WITNESS STAKE" STA. 159+79.45 STA. +05 SHOWN ON S. SIDE OF CHURCH

- B. Description of corner evidence found and/or method applied in restoring or reestablishing corner: 1994 ROWE ENG. - FIELD, P.S.#37276; FND 3/4" ROD IN MON. BOX 3' W. OF C/L ASPH. ROAD N-S & ON C/L OF ASPH. ROAD TO W. FND S. EDGE OF OLD CHURCH BLDG. TO BE 107' +/- N. OF MON. BOX & FND PHONE RISER N40°E, 51.6' BOTH INDICATING THAT FND ROD IS IN APPROX. SAME POSITION AS 1924 GENESEE CO. RD. COMM. PIPE

ACCEPTED 3/4" ROD AS A CAREFUL AND FAITHFUL PERPETUATION OF THE ORIGINAL CORNER POSITION RATIFIED BY GEN. CO. PEER GROUP NOV. 9, 1994

- C. Description of monument for corner and accessories established to perpetuate locating the position of the corner: M-11 SET STANDARD GENESEE CO. MONUMENT OVER FND 3/4" ROD IN MON. BOX S40°E, 45.77' FND NAIL W/ DELTA ENG. TAG IN SW FACE TWIN 10" ASH S40°E, 45.50' FND P-K NAIL IN SW FACE TWIN 10" ASH S45°W, 67.18' FND NAIL W/ DELTA ENG. TAG IN SE FACE 10" ELM S45°W, 67.30' FND NAIL IN SE FACE 10" ELM N60°W, 68.61' FND NAIL W/ DELTA ENG. TAG IN SE FACE P.POLE N60°W, 68.93' FND NAIL W/TAG #12024 IN S. FACE P.POLE N25°W, 115.62' SE COR. OF BRICK HOUSE #10111 (OLD CHURCH) N40°W, 47.84' SW COR. RD. SIGN POST

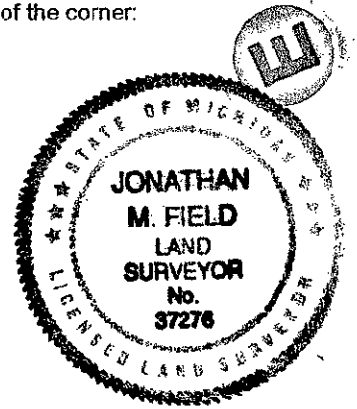

73975

Signed by Jonathan M. Field Ratified by Peer Group in accordance with P.A. 345, 1990

Surveyor's Michigan License No. 37276 Co. Rep. Carl Carlson \$900 Date Nov 9, 1994 Filed + Rec