

GLADWIN COUNTY REMONUMENTATION

LAND CORNER RECORDATION CERTIFICATE
Filing Requirement of Act 74, Mich. P.A. 1970

LIBER 001 PAGE 200

For corners in

GLADWIN

(County)

Located In:

Corner Code #

1. Public Land Survey

T 17N R 1E

K-9

2. Property Controlling
in Section

S T R

3. Miscellaneous
Property in Sec.

S T R

4. Lot No. _____, Recorded Plat _____

5. Private Claims _____

STATE OF MICHIGAN
GLADWIN COUNTY
FILED - Remonumentation

17 OCT 97 1:24 P.M.

BONNIE K. HOUSE
REGISTER OF DEEDS
Register of Deeds Stamp & File Number

I, MARK R. ROBISON, in a field survey on July 25, 1997 do hereby state that under requirements of P.A. 74, Michigan P.A. of 1970, the corner points mentioned in lines 1 and 2 above were in conformance with regulations and rules therefore as required in the current manual of survey instructions of the United States Department of the Interior, Bureau of Land Management or by a decree of a Court of Law and /or that the corner points mentioned in lines 3, 4 and 5 above were in conformance with the rules of the Michigan Board of Land Surveyors or by a Decree of a Court of Law; established, re-established, monumented, recovered, found as expressed below:

NOTE: Not more than 2 corners, all in the same town and range, may be recorded on this certificate.

- A. Description of original monument and accessories and/or subsequent restoration:
- 1831 Henry Parke Set Post
Wit.-(1)N45W 17 links 8" Pine
(2)S3E 5 links 5" Pine
 - 1964 Lapham-Found T-iron
Wit.-same as (3) & (4)
 - 1964 American Civil Engineers Found T-iron
Wit.-(3)SW NE Cor Lot 1 51.82
(4)SE Cor Post 40.39
 - 1974 Sedgman-Found 1/2" bar (reset)
Wit.-(5)S45W 78.65 NE Cor of House
(6)N45W 100.49 10" Maple
(7)N30E 101.74 4" W. Pine
 - 1974 Lapham L.C.R.C.#74
Wit.-same as (5),(6)&(7)

| | A | B | C | D | E | F | G | H | I | J | K | L | M |
|----|----|---|----|---|----|---|----|---|----|---|----|---|---|
| 1 | | | | | | | | | | | | | |
| 2 | 6 | | 5 | | 4 | | 3 | | 2 | | 1 | | |
| 3 | | | | | | | | | | | | | |
| 4 | 7 | | 8 | | 9 | | 10 | | 11 | | 12 | | |
| 5 | | | | | | | | | | | | | |
| 6 | 16 | | 17 | | 16 | | 15 | | 14 | | 13 | | |
| 7 | | | | | | | | | | | | | |
| 8 | 19 | | 20 | | 21 | | 22 | | 23 | | 24 | | |
| 9 | | | | | | | | | | | | | |
| 10 | 30 | | 29 | | 28 | | 27 | | 26 | | 25 | | |
| 11 | | | | | | | | | | | | | |
| 12 | 31 | | 32 | | 33 | | 34 | | 35 | | 36 | | |
| 13 | | | | | | | | | | | | | |

1977 Edmands Eng. L.C.R.C.#169
Found Iron
Wit.-(8)SW 78.8 to NE Cor School Bldg
(9)SE 50.0 to Cor. Fe. Post
(10)SW 42.7 P. Pole

B. Description of corner evidence found and/or method applied in restoring or reestablishing corner:

Found 1/2" x 18" rerod (old) 6" below surface in centerline of bituminous North, South, & West T-road-agrees with witness (6), (8) & (10).
Set Gladwin County Re-mon in place of found 1/2" rerod.

See dossier for detailed report.

APPROVED LAND CORNER
P.A. 345 of 1990
Gladwin County

Co. Rep. [Signature]
Date 9/18/97

C. Description of monument for corner and accessories established to perpetuate locating the position of the corner:

K-9: Corner common to Sections 23, 24, 25 & 26.
Set 5/8" x 36" rerod with Gladwin County Re-mon Cap marked P.S.#27458 in Monument Box.


Witnesses:
S45W NE Cor House, Blk Foundation, 78.82'
N45W 10" Maple, nail & tag, 100.49'
N50E 5" Maple, nail & tag, 77.21'
North, P.K. nail, 2.0'
S75E 8" Maple, nail & tag, 78.19'
East, P.K. nail, 2.0'

SURVEY &
REMONUMENTATION

JAN 08 1998

SECTION

Signed by [Signature]
Surveyor's Michigan License No. 27458

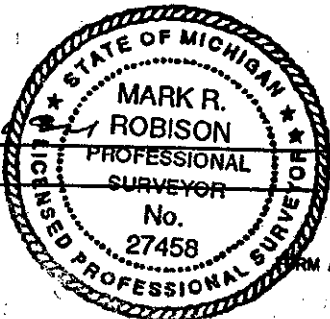

Date 10-7-97