

GLADWIN COUNTY REMONUMENTATION

LAND CORNER RECORDATION CERTIFICATE
Filing Requirement of Act 74, Mich. P.A. 1970

LIBER 001 PAGE 203

For corners in

<u>GLADWIN</u> (County)	Located in:	Corner Code #
1. Public Land Survey	T <u>17N</u> R <u>1E</u>	<u>L-3</u>
	T <u> </u> R <u> </u>	<u> </u>
	T <u> </u> R <u> </u>	<u> </u>
	T <u> </u> R <u> </u>	<u> </u>
2. Property Controlling in Section	S <u> </u> T <u> </u> R <u> </u>	<u> </u>
	S <u> </u> T <u> </u> R <u> </u>	<u> </u>
3. Miscellaneous Property in Sec.	S <u> </u> T <u> </u> R <u> </u>	<u> </u>
	S <u> </u> T <u> </u> R <u> </u>	<u> </u>
4. Lot No. _____, Recorded Plat _____		
5. Private Claims _____		

STATE OF MICHIGAN
GLADWIN COUNTY
FILED -Remonumentation

17 OCT 97 1:24 P.M.

BONNIE K. HOUSE
REGISTER OF DEEDS

Register of Deeds Stamp & File Number

A	B	C	D	E	F	G	H	I	J	K	L	M
1												
2	6		5		4		3		2		1	
3												
4	7		8		9		10		11		12	
5												
6	18		17		16		15		14		13	
7												
8	19		20		21		22		23		24	
9												
10	30		29		28		27		26		25	
11												
12	31		32		33		34		35		36	
13												

I, MARK R. ROBISON, in a field survey on January 14, 19 97, do hereby state that under requirements of P.A. 74, Michigan P.A. of 1970, the corner points mentioned in lines 1 and 2 above were in conformance with regulations and rules therefore as required in the current manual of survey instructions of the United States Department of the Interior, Bureau of Land Management or by a decree of a Court of Law and for that the corner points mentioned in lines 3, 4 and 5 above were in conformance with the rules of the Michigan Board of Land Surveyors or by a Decree of a Court of Law; established, re-established, monumented, recovered, found as expressed below:

NOTE: Not more than 2 corners, all in the same town and range, may be recorded on this certificate.

A. Description of original monument and accessories and/or subsequent restoration:

1831 Henry Parke
Set Post
Wit.-(1)N12W 7 links 24" Pine
(2)S64E 43 links 12" Beech

1989 Lapham survey
Wit.-same as (3),(4)&(5)

1975 Lapham L.C.R.C.#112 & survey
Set capped iron
Wit.-(3)S45E 12.25' - 6" White Oak
(4)N10E 34.75' - 8" Twin R. Oak
(5)S30E 40.45' - 12" R. Oak

1991 D.N.R.-Roser
Found 1/2" x 18" rored (Lapham)
added D.N.R. monument & Cedar post
Wit.-(6)14" Twin R. Oak N20E 34.75'
(7)14" Twin R. Oak S25E 40.45'
(8)12" W. Oak S45W 12.25'

APPROVED LAND CORNER
P.A. 345 of 1990
Gladwin County

Co. Rep. [Signature]
Date 10/18/97

B. Description of corner evidence found and/or method applied in restoring or reestablishing corner:

Found D.N.R. monument and 1/2" x 18" rored with cap 100' +/- East of center trail in wooded area marked with Cedar post. Found witnesses (3),(4) & (5) as recorded and measured.

See dossier for detailed report.

C. Description of monument for corner and accessories established to perpetuate locating the position of the corner:

L-3: Corner common to Sections 1 & 12
Accepted D.N.R. monument and capped iron #9433 as in place.


Witnesses:
N20E 14" Twin Red Oak, spike, 34.75'
S25E 14" Twin Red Oak, spike, 40.45'
S45W 12" White Oak, spike, 12.25'
East 8" Red Oak, nail & tag, 21.09'

SURVEY &
REMONUMENTATION

JAN 08 1998

SECTION

Signed by [Signature]
Surveyor's Michigan License No. 27458

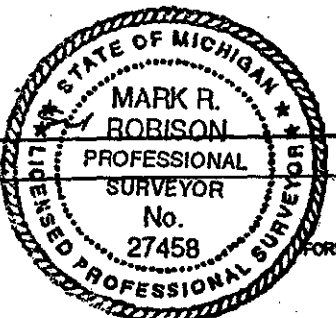

Date 10-7-97