LAND CORNER RECORDATION CERTIFICATE

Filing Requirement of Act 74, Mich. P.A. 1970

For corners in SLADWIN
(County)

	Located In:		Corner Code ##
1. Public Land Survey	T 17N R 1E		L-5
	T ___ R ___		
	T ___ R ___		
	T ___ R ___		
2. Property Controlling	S 12 T ___ R ___		12
in Section	S ___ T ___ R ___		
3. Miscellaneous	S ___ T ___ R ___		
Property in Sec.	S ___ T ___ R ___		

Register of Deeds Stamp & File Number

4. Lot No. _____ , Recorded Plat _____
5. Private Claims _____

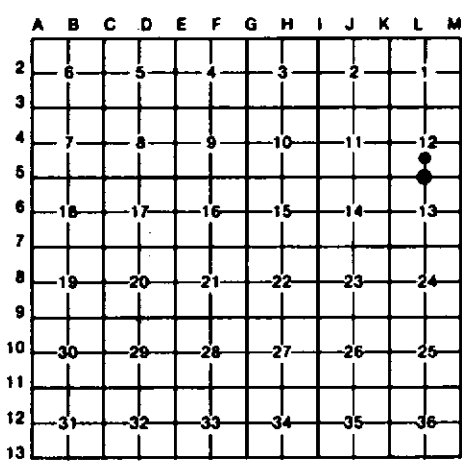

I, C.F.ROSER, in a field survey on 8-24, 19 89, do hereby certify that under requirements of P.A. 74, Michigan P.A. of 1970, the corner points mentioned in lines 1 and 2 above were in conformance with regulations and rules therefore as required in the current manual of survey instructions of the United States Department of the Interior, Bureau of Land Management or by a decree of a Court of Law and/or that the corner points mentioned in lines 3, 4 and 5 above were in conformance with the rules of the Michigan Board of Land Surveyors or by a Decree of a Court of Law; established, re-established, monumented, re-monumented, recovered, found as expressed below:

NOTE: Not more than 4 corners, all in the same town and range, may be recorded on this certificate.

A. Description of original monument and accessories and/or subsequent restoration:

L-5	12
FD 1/2" IRON BAR W/CAP. BY J.BEDGNAN FOR S1/4 COR S-12. K.OSTLING ACCEPTED THIS COR IN HIS 1982 DNR SURVEY TO SUBDIVIDE THE E1/2 OF SEC 12.	FD. 5/8" REROD AS SET BY LS. K.OSTLING, IN 1982 DNR SURVEY. PER STANDARD SURVEY PROCEDURE FOR THE SUBDIVISION OF SECTION.

B. Description of corner evidence found and/or method applied in restoring or reestablishing corner:

L-5	12
FD 1/2" IRON BAR W/CAP. BY J.BEDGNAN FOR S1/4 COR S-12. K.OSTLING ACCEPTED THIS COR IN HIS 1982 DNR SURVEY TO SUBDIVIDE THE E1/2 OF SEC 12.	FD. 5/8" REROD AS SET BY LS. K.OSTLING, IN 1982 DNR SURVEY. PER STANDARD SURVEY PROCEDURE FOR THE SUBDIVISION OF SECTION.

C. Description of monument for corner and accessories established to perpetuate locating the position of the corner:

L-5			12		
FD 1/2" IRON ROD W/LS CAP.			FD 5/8"x 34" REROD. ADDED LS CAP.		
1"W.BIRCH	DUE E	29.1'	4"MAPLE	S45°E	53.9'
CTR E. END OF 14" CM CULVERT	S10°E	101.5'	*7"MAPLE	S45°W	38.6'
CTR W. END OF 14" CM CULVERT.	S12°W	101.1'	*22"R.OAK	N80°W	29.1'
SET CED POST W/LOC TAG	DUE W	25'	*CED POST W/LOC TAG	W.	30'

* = LS K.OSTLING WIT.

STATE OF MICHIGAN
CARL F. ROSER
LAND SURVEYOR
No. 12028
REGISTERED LAND SURVEYOR

Signed by Carl F. Roser 1-24-91 Date _____

Surveyor's Michigan License No. 12028

FORM APPROVED BY MICHIGAN STATE BOARD OF LAND SURVEYORS, JAN. 29, 1971
REVISED MAY 14, 1975
REVISED JAN., 1983