LAND CORNER RECORDATION CERTIFICATE

Filing Requirement of Act 74, Mich. P.A. 1970

For corners in BLANKIN (County)

	Located In:	Corner Code ##
1. Public Land Survey	T 17N R 1E	L-3
	T ___ R ___	
	T ___ R ___	
	T ___ R ___	
2. Property Controlling	S 12 T ___ R ___	1,4,8
in Section	S ___ T ___ R ___	
3. Miscellaneous	S ___ T ___ R ___	
Property in Sec.	S ___ T ___ R ___	

Register of Deeds Stamp & File Number

4. Lot No. _____, Recorded Plat _____
5. Private Claims _____

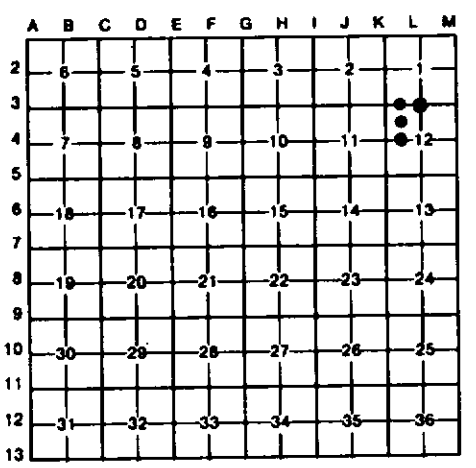

I, C.F.ROSER, in a field survey on 8-23-89, 19 ____, do hereby certify that under requirements of P.A. 74, Michigan P.A. of 1970, the corner points mentioned in lines 1 and 2 above were in conformance with regulations and rules therefore as required in the current manual of survey instructions of the United States Department of the Interior, Bureau of Land Management or by a decree of a Court of Law and/or that the corner points mentioned in lines 3, 4 and 5 above were in conformance with the rules of the Michigan Board of Land Surveyors or by a Decree of a Court of Law; established, re-established, monumented, re-monumented, recovered, found as expressed below:

NOTE: Not more than 4 corners, all in the same town and range, may be recorded on this certificate.

A. Description of original monument and accessories and/or subsequent restoration:

L-3: 1 4 8

B. Description of corner evidence found and/or method applied in restoring or reestablishing corner:

L-3
FD. 1/2" REROD FOR N 1/4 COR SEC. 12 AS ESTABLISHED BY L.S. P.LAPHAM IN 1975 SURVEY IN SEC. 1, T17N-R1E.

1
FD. 4" ROUND CONC. MON. FOR NW COR OF NE 1/4 OF FRL. NW 1/4 SEC. 12.

4
FD. ROUND CONC. MON. FOR CTR. OF FRL. NW1/4 S-12. THIS COR. IS PROBABLY A RESULT OF W.S.MOORE'S SURVEY FOR SUPERVISORS PLAT OF "KLOPF'S LANDING" IN FRL. NW1/4-FRL NW1/4 S-12 IN 1957-58.

8
ESTAB. SW COR OF SE1/4 OF FRL NW1/4 OF SEC 12, AT INTERSECTION OF; LINE ACROSS FD KJO CTR OF SEC 12 AND CALC M.O.L. POSITION BETWEEN KJO FD N1/8 ON N. LINE S-12 & KJO FD N1/8 ON S. LINE S-12, AND LINE ACROSS FD SQ. CONC MON TO NORTH (N00°01'05"W. 23.03) AND KJO FD N1/8 ON SOUTH LINE SEC 12 (SEE WORKING DRAWING, DNR PROJ NO. 26-93433).

C. Description of monument for corner and accessories established to perpetuate locating the position of the corner:

L-3
FD 1/2"x 18" REROD WITH CAP, ADDED DNR MON AND CEDAR POST.

#14"TN.R.OAK	N20°E	34.75'
#14"TN.R.OAK	S25°E	40.45'
#12"W.OAK	S45°W	12.25'
CTR.TRAIL	DUE W	99'±3'

1
FD. 4" ROUND CONC MON. ADDED CED. POST W/LOC. TAG.

7"TN.MAPLE	N05°W	2.2'
3"MAPLE	N75°E	20.8'
3"R.OAK	S70°E	20.2'
11"MAPLE	S40°W	17.8'

4
FD. 4" ROUND CONC.MON. ADDED CEDAR POST W/LOC TAG.

9"&13" W.OAKS	N05°E	19.5'
13"ASH	S10°E	10.3'
4"R.OAK	S45°W	7.3'
CTR.BIT.RD.	DUE N	126'
FD. ROUND CONC MON (SLY RD. ROW MON)	N00°04'W	84.59'

8
DROVE 5/8"x 34" REROD W/LS CAP AND SET CED POST W/LOC TAG.

3"ASH	N65°W	5.2'
14"MAPLE	N80°E	38.9'
9"ASH	S35°W	3.3'
FD 4"SQ CONC MON.	N00°01'W	23.03'
CTR TRAIL RD. TO CABINS	DUE W.	103'

= L.S., MEYERS B.T.

Signed by Carl F. Roser 1-24-91 Date _____

Surveyor's Michigan License No. 12028

STATE OF MICHIGAN CARL F. ROSER LAND SURVEYOR No. 12028 REGISTERED LAND SURVEYOR

FORM APPROVED BY MICHIGAN STATE BOARD OF LAND SURVEYORS, JAN. 28, 1971
REVISED MAY 14, 1975
REVISED JAN., 1983