

# LAND CORNER RECORDATION CERTIFICATE

## FILING REQUIREMENT OF ACT 74, MICH. P.A.1970

FOR CORNERS OF--:	LOCATED IN--:	CORNER CODE NUMBER
1. PUBLIC LAND SURVEY _____	T. <u>17</u> N. S., R. <u>1</u> E. W.	<u>M-4, M-3</u>
2. PROPERTY CONTROLLING IN SECTION <u>12</u>	, T. <u>17</u> N. S., R. <u>1</u> E. W.	<u>7, 14</u>
3. MISCELLANEOUS PROPERTY IN SECTION _____	, T. _____ N. S., R. _____ E. W.	_____
4. LOT NO. _____, RECORDED PLAT _____		
5. PRIVATE CLAIMS _____		

REGISTER OF DEEDS STAMP AND FILING NUMBER

I, Kenneth J. Ostling, do hereby certify that under requirements of P.A. 74, Michigan P.A. of 1970, the corner points mentioned in lines 1 and 2 above were, in a field survey on May 27, 1981, established, re-established, monumented, re-monumented, recovered or restored as expressed below and in conformance with regulations and rules therefore as required in the current manual of survey instructions of the United States Department of the Interior, Bureau of Land Management or by a decree of a court of law. Furthermore, that the corner points mentioned in lines 3, 4 and 5 above were, in a field survey on \_\_\_\_\_, 19\_\_\_\_, found, recovered, restored, established or re-established as expressed below and in conformance with the rules of the Michigan State Board of Registration for Land Surveyors or, by a Decree of a Court of law:

A. Description of original monument and accessories and/or subsequent restoration:

B. Description of corner evidence found and/or method applied in restoring or re-establishing corner:


- M-4 Fd. 1 1/2" pipe at corner as established in 1937± C.C.C. survey.
- M-3 Fd 1 1/2" pipe near proper location for corner. Replaced at proper relation to NW corner of Sec. 7, on section line.
- 7 Found 1 1/2" pipe at corner as placed in 1930's survey by C.C.C. project.
- 14 Set by standard survey procedure for the subdivision of sections.

C. Description of monument for corner and accessories established to perpetuate locating the position of the corner:

M-4	M-3	7
Set 1" x 36" iron pipe w/cap in place of 1 1/2" pipe, also fd. point of old post	1" x 36" iron pipe with 4" cap 6" R. Maple S52°W 18.3' 6" R. Maple N39°W 33.1'	Found 1 1/2" pipe in place 4" R. Pine N13°W 19.0' 4" R. Pine S87°W 35.2'
No witnesses available		

14  
Set 5/8" x 3/8" steel rod w/cap  
No witnesses available

SIGNED BY Kenneth J. Ostling DATE \_\_\_\_\_  
 SURVEYOR'S MICHIGAN REGISTRATION NO. 10068

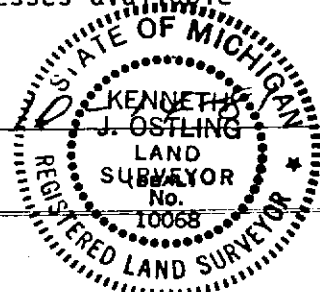

FOR STATE AND UNITED STATES AGENCIES:

SIGNED BY \_\_\_\_\_ DATE \_\_\_\_\_  
CHIEF OF SURVEY PARTY  
 APPROVED AND SIGNED BY \_\_\_\_\_ DATE \_\_\_\_\_  
MICHIGAN REGISTERED LAND SURVEYOR (SEAL)

SURVEYOR'S MICHIGAN REGISTRATION NO. \_\_\_\_\_ GLADWIN COUNTY