

LAND CORNER RECORDATION CERTIFICATE

FILING REQUIREMENT OF ACT 74, MICH. P.A.1970

FOR CORNERS OF--:	LOCATED IN--:	CORNER CODE NUMBER
1. PUBLIC LAND SURVEY <u>12</u>	T. <u>17</u> N. <u>1</u> E. <u>1</u>	<u>L-4</u>
2. PROPERTY CONTROLLING IN SECTION <u>12</u>	, T. <u>17</u> N. <u>1</u> E. <u>1</u>	<u>6; 9</u>
3. MISCELLANEOUS PROPERTY IN SECTION _____	, T. _____ N. _____ E. _____	_____
4. LOT NO. _____	RECORDED PLAT _____	_____
5. PRIVATE CLAIMS _____	_____	_____

REGISTER OF DEEDS STAMP AND FILING NUMBER

I, KENNETH J. OSTLING, do hereby certify that under requirements of P.A. 74, Michigan P.A. of 1970, the corner points mentioned in lines 1 and 2 above were, in a field survey on APRIL 22, 1982, established, re-established, monumented, re-monumented, recovered or restored as expressed below and in conformance with regulations and rules therefore as required in the current manual of survey instructions of the United States Department of the Interior, Bureau of Land Management or by a decree of a court of law. Furthermore, that the corner points mentioned in lines 3, 4 and 5 above were, in a field survey on _____, 19____, found, recovered, restored, established or re-established as expressed below and in conformance with the rules of the Michigan State Board of Registration for Land Surveyors or, by a Decree of a Court of law:

A. Description of original monument and accessories and/or subsequent restoration:

B. Description of corner evidence found and/or method applied in restoring or re-establishing corner:

- L-4 SET BY STANDARD SURVEY PROCEDURE AT INTERSECTION OF 1/4 LINES.
- 6 SET BY STANDARD SURVEY PROCEDURE FOR THE SUBDIVISION OF SECTIONS.
- 9 SET BY STANDARD SURVEY PROCEDURE FOR THE SUBDIVISION OF SECTIONS.

C. Description of monument for corner and accessories established to perpetuate locating the position of the corner:

<u>L-4</u>	<u>6</u>	<u>9</u>
SET 5/8" ROD W/RLS CAP BELOW SURFACE	SET 5/8" ROD WITH CAP	SET 5/8" ROD WITH CAP
6" W. PINE S53°W 41.7'	5" R. MAPLE N64°E 9.7'	4" R. MAPLE N35°W 26.5'
SET 5" CEDAR POST WITH LOCATION TAG	5" R. MAPLE S83°W 15.4'	4" R. MAPLE S28°W 32.8'
N85°W 30.0'		


SIGNED BY Kenneth J. Ostling DATE 9

SURVEYOR'S MICHIGAN REGISTRATION NO. #10068

FOR STATE AND UNITED STATES AGENCIES:

SIGNED BY _____ DATE _____
CHIEF OF SURVEY PARTY

APPROVED AND SIGNED BY _____ DATE _____
MICHIGAN REGISTERED LAND SURVEYOR

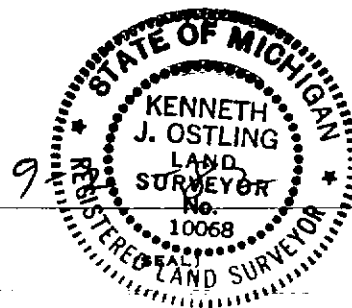

SURVEYOR'S MICHIGAN REGISTRATION NO. _____

GLADWIN COUNTY