

LAND CORNER RECORDATION CERTIFICATE

FILING REQUIREMENT OF ACT 74, MICH. P.A.1970

FOR CORNERS OF--:	LOCATED IN--:	CORNER CODE NUMBER
1. PUBLIC LAND SURVEY _____	T. <u>17</u> N. S., R. <u>2</u> E. W.	<u>C-5, C-3, C-4</u>
2. PROPERTY CONTROLLING IN SECTION _____	T. _____ N. S., R. _____ E. W.	_____
3. MISCELLANEOUS PROPERTY IN SECTION _____	T. _____ N. S., R. _____ E. W.	_____
4. LOT NO. _____, RECORDED PLAT _____		
5. PRIVATE CLAIMS _____		

REGISTER OF DEEDS STAMP AND FILING NUMBER

I, Kenneth J. Ostling, do hereby certify that under requirements of P.A. 74, Michigan P.A. of 1970, the corner points mentioned in lines 1 and 2 above were, in a field survey on May 28, 19 81, established, re-established, monumented, re-monumented, recovered or restored as expressed below and in conformance with regulations and rules therefore as required in the current manual of survey instructions of the United States Department of the Interior, Bureau of Land Management or by a decree of a court of law. Furthermore, that the corner points mentioned in lines 3, 4 and 5 above were, in a field survey on _____, 19____, found, recovered, restored, established or re-established as expressed below and in conformance with the rules of the Michigan State Board of Registration for Land Surveyors or, by a Decree of a Court of law:

A. Description of original monument and accessories and/or subsequent restoration:


B. Description of corner evidence found and/or method applied in restoring or re-establishing corner:

- C-5 Found old squared post lying down. Witness stump 36" W. Pine stp N15°W, 31.4' with blaze and notch.
- C-3 Found 2 wood post bottoms in N-S road grade, probably as established in 1930's C.C.C. survey project.
- C-4 Set corner on line between section corners, at proportionate measurement to that recorded in 1930's survey for this mile. Fits acceptably with fences in N1/2 mile.

C. Description of monument for corner and accessories established to perpetuate locating the position of the corner:

C-5	C-3	C-4
Set DNR Mon.	Set DNR Mon.	1" x36" iron pipe w/4" cap
4" R. Maple S73°W 30.8'	6" Ash S72E 9.6'	10" R. Maple S14°W 36.1'
4" R. Maple N59°W 30.1'	4" Maple N54W 13.4'	4" R. Maple N30°W 12.0'
	Ced. Post W 7'	

SIGNED BY *Kenneth J. Ostling* DATE _____
 SURVEYOR'S MICHIGAN REGISTRATION NO. 10068

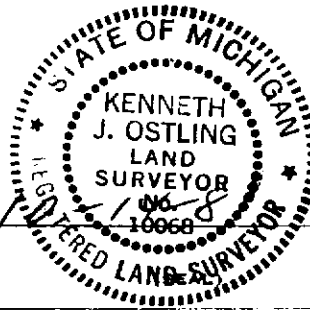

FOR STATE AND UNITED STATES AGENCIES:

SIGNED BY _____ DATE _____
CHIEF OF SURVEY PARTY
 APPROVED AND SIGNED BY _____ DATE _____
MICHIGAN REGISTERED LAND SURVEYOR

(SEAL)

SURVEYOR'S MICHIGAN REGISTRATION NO. _____

GLADWIN COUNTY