

AUG 23 2000

SECTION

LAND CORNER RECORDATION CERTIFICATE
Filing Requirement of Act 74, Mich. P.A. 1970
Gladwin County Remonumentation

LIBER 001 PAGE 300

For Corners in
GLADWIN
(County)

Located In: Corner Code#:

- 1. Public Land Survey T. 17N R. 2W A-11
2. Public Controlling in Section S. T. R.
3. Miscellaneous Property in Section S. T. R.
4. Lot No., Recorded Plat
5. Private Claims

STATE OF MICHIGAN
GLADWIN COUNTY
FILED-REMONUMENTATION
10 AUG 2000 11:18:45 AM
BONNIE K. HOUSE
REGISTER OF DEEDS

Register of Deeds Stamp & File Number

I, Mark R. Robison, in a field survey on March 2000, do hereby certify that under requirements of P.A. 74, Michigan P.A. of 1970, the corner points mentioned in lines 1 and 2 above were in conformance with regulations and rules therefore as required in the current manual of survey instructions of the United States Department of the Interior, Bureau of Land Management or by a decree of a Court of Law and/or that the corner points mentioned in lines 3, 4 and 5 above were in conformance with the rules of the Michigan Board of Land Surveyors or by a Decree of a Court of Law, established, re-established, monumented, re-monumented, recovered, found as expressed below.

Grid table with columns A-M and rows 1-13. Row 2: 6, 5, 4, 3, 2, 1. Row 4: 7, 8, 9, 10, 11, 12. Row 6: 18, 17, 16, 15, 14, 13. Row 8: 19, 20, 21, 22, 23, 24. Row 10: 30, 29, 28, 27, 26, 25. Row 12: 31, 32, 33, 34, 35, 36.

NOTE: Not more than 2 corners, all in the same town and range, may be recorded on this certificate.

A. Description of original monument and accessories and/or subsequent restoration:

1831 R. Clark
Pine 36" in diam for cor sec's 25 & 36

1974 John Radcliffe
LCRC#101
Found 1/2" re-bar
Wit-(6)Fe. Post, N45°E, 46.36'
(7)10" Poplar, N70°W, 66.13'
(8)10" Poplar, S50°W, 37.08'

1917 C.S.R.
Wit-(1)Pine 30 S45°30E 73
(2)Pine 24 S33W 31

1972 A.V. Courtwright
LCRC#89-73 Found 5/8" Rod
Wit-(3)Cor. Fe. Post, North, 28.57'
(4)Cor. Fe. Post, South, 28.63'
(5)Fe. Post, S40°E, 41.23'

1989 Lapham
working drawing
Wit-same as (6), (7) & (8)

APPROVED LAND CORNER
P.A. 345 of 1990
Gladwin County

Co. Rep. [Signature]
Date 8-2-00

B. Description of corner evidence found and/or method applied in restoring or re-establishing corner:


Found 5/8" x 18 rebar, bent on top, in centerline East-West road opposite old corner and fence to the South (down). Agrees with witnesses (6) Recorded 46.36'; measured 46.35' double headed nail and (3) Recorded 28.57; measured 28.5+/-, reconstructed (down) fence corner North to upright position. Accepted found 5/8" x 18" Bar as corner of record; replaced with 5/8" x 36" rerod.

See dossier for detailed report on corner A-11.

C. Description of monument for corner and accessories established to perpetuate locating the position of the corner:

Set 5/8" x 36" rerod with Gladwin Remonumentation cap marked P.S. 27458. Accepted as best available evidence to perpetuate position of corner A-11.

Witnesses:
S52°E 4" Spruce, nail & tag, 89.15'
N45°E 10" W. Pine, nail & tag, 48.95'
North 8" x 8" Gate Post, nail & tag, 27.75'
S30°W 6" Ash, nail & tag, 44.40'

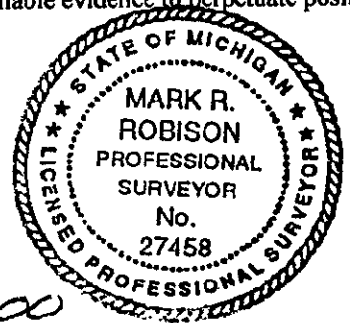

Signed by [Signature]
Surveyor's Michigan License No. 27458

Date 8-9-00