

AUG 23 2000

SECTION

LAND CORNER RECORDATION CERTIFICATE
Filing Requirement of Act 74, Mich. P.A. 1970
Gladwin County Remonumentation

LIBER 001 PAGE 301

For Corners in
GLADWIN

(County)

Located In:

Corner Code#:

- 1. Public Land Survey T. 17N R. 2W A-12
2. Public Controlling in Section S. T. R.
3. Miscellaneous Property in Section S. T. R.
4. Lot No., Recorded Plat
5. Private Claims

STATE OF MICHIGAN
GLADWIN COUNTY
FILED-REMONUMENTATION

10 AUG 2000 11:18:57 AM

BONNIE K. HOUSE
REGISTER OF DEEDS

Register of Deeds Stamp & File Number

Grid table with columns A-M and rows 1-13. Row 2: 6, 5, 4, 3, 2, 1. Row 4: 7, 8, 9, 10, 11, 12. Row 6: 18, 17, 16, 15, 14, 13. Row 8: 19, 20, 21, 22, 23, 24. Row 10: 30, 29, 28, 27, 26, 25. Row 12: 31, 32, 33, 34, 35, 36.

I, Mark R. Robison, in a field survey on April 2000, do hereby certify that under requirements of P.A. 74, Michigan P.A. of 1970, the corner points mentioned in lines 1 and 2 above were in conformance with regulations and rules therefore as required in the current manual of survey instructions of the United States Department of the Interior, Bureau of Land Management or by a decree of a Court of Law and/or that the corner points mentioned in lines 3, 4 and 5 above were in conformance with the rules of the Michigan Board of Land Surveyors or by a Decree of a Court of Law, established, re-established, monumented, re-monumented, recovered, found as expressed below.

NOTE: Not more than 2 corners, all in the same town and range, may be recorded on this certificate.

A. Description of original monument and accessories and/or subsequent restoration:

1831 R. Clark
Set QR. Post in Swamp
Wit-(1)Black Ash 10 S8W 39
(2)Do 10 N25W 16

1972 A.V. Courtwright
LCRC#89-73, survey, & section subd.
Set 5/8" x 18" Stl. Rod M.O.L.
Wit-(3)14" Triple Maple, N02°W, 10.02'
(4)12" Twin Maple, S70°E, 9.45'
(5)10" Twin Maple, S65°W, 23.15'

1999 Lapham--survey
Found 5/8" x 18" Stl. Rod
Wit-same as (3), (4) & (5)

B. Description of corner evidence found and/or method applied in restoring or re-establishing corner:

Found 5/8" x 18" capped iron in swamp, 22'+/- East and 12' +/- North of old fence intersection (fences run North and West) --no record of (survey recorded in county survey records). Agrees with Courtwright's witnesses (3), (4) & (5). Accepted found 5/8" capped iron as corner of record; replaced with 5/8" x 36" rered.


See dossier for detailed report on corner A-12.

APPROVED LAND CORNER
P.A. 345 of 1990
Gladwin County
Co. Rep. [Signature]
Date 8-2-00

C. Description of monument for corner and accessories established to perpetuate locating the position of the corner:

Set 5/8" x 36" rered with Gladwin Remonumentation cap marked P.S. 27458. Accepted as best available evidence to perpetuate position of corner A-12.

Witnesses:
S80°W 16" Maple, nail & tag, 23.45'
S45°W 6" Maple, nail & tag, 3.05'
S85°E Twin 12" & 16" Maple, nail & tag, 9.60'
N10°W Twin 12" & 16" Maple, nail & tag, 9.75'

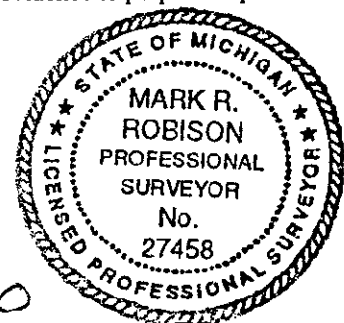

Signed by [Signature]
Surveyor's Michigan License No. 27458

Date 8-9-00