

SURVEY & REMONUMENTATION

SEP 07 1999

SECTION

LAND CORNER RECORDATION CERTIFICATE
Filing Requirement of Act 74, Mich. P.A. 1970
Gladwin County Remonumentation

LIBER 001 PAGE 267

STATE OF MICHIGAN
 GLADWIN COUNTY
 Filled Remon

16 AUG 1999 2:35:23 PM

BONNIE K. HOUSE
 REGISTER OF DEEDS

For Corners in
GLADWIN
 (County)

	Located In:	Corner Code#:
1. Public Land Survey	T. <u>17N</u> R. <u>2W</u>	<u>B-5</u>
	T. _____ R. _____	_____
	T. _____ R. _____	_____
2. Public Controlling in Section	S. _____ T. _____ R. _____	_____
	S. _____ T. _____ R. _____	_____
3. Miscellaneous Property in Section	S. _____ T. _____ R. _____	_____
	S. _____ T. _____ R. _____	_____
4. Lot No. _____, Recorded Plat _____		
5. Private Claims		

Register of Deeds Stamp & File Number

I, Mark R. Robison, in a field survey on May 6, 1999, do hereby certify that under requirements of P.A. 74, Michigan P.A. of 1970, the corner points mentioned in lines 1 and 2 above were in conformance with regulations and rules therefore as required in the current manual of survey instructions of the United States Department of the Interior, Bureau of Land Management or by a decree of a Court of Law and/or that the corner points mentioned in lines 3, 4 and 5 above were in conformance with the rules of the Michigan Board of Land Surveyors or by a Decree of a Court of Law, established, re-established, monumented, re-monumented, recovered, found as expressed below.

NOTE: Not more than 2 corners, all in the same town and range, may be recorded on this certificate.

	A	B	C	D	E	F	G	H	I	J	K	L	M
1													
2	6	5	4	3	2	1							
3													
4	7	8	9	10	11	12							
5													
6	18	17	16	15	14	13							
7													
8	19	20	21	22	23	24							
9													
10	30	29	28	27	26	25							
11													
12	31	32	33	34	35	36							
13													

A. Description of original monument and accessories and/or subsequent restoration:

1850 William A. Burt
 Set QR. Post
 Wit-(1) Maple 16 N52E 25
 (2) W. Pine 26 S67W 21

1966 Lapham field notes
 Set Bolt Spike

1987 Lapham survey
 Wit-same as (7), (8) & (9)

1951 McCartney county road plans
 Set Rod over Found Stake & Stone
 Wit-(3) N20E 42.73 12" Beasch ?
 (4) N40E 74.30 14" Elm
 (5) N Fe. 27.4
 (6) S Fe. 31.7

1972 Lapham LCRC#32B, survey & working drawing
 Wit-(7) South 32.07 Fe. Cor.
 (8) N05E 45.74 2" Birch
 (9) North 39.60 Fence Cor.

1979 Lapham survey
 Wit-same as (7), (8) & (9)

B. Description of corner evidence found and/or method applied in restoring or re-establishing corner:

Found 3/8" x 6" roerod in centerline of road opposite fences North & South. Agrees with witnesses (7) & (9). Also agrees with county road plans (1951) and Lapham (1972) & (1979) measurements to C-5. Set 5/8" roerod in place of found 3/8" roerod.

See dossier for detailed report.


APPROVED LAND CORNER
P.A. 345 of 1990
Gladwin County

Co. Rep. [Signature]
 Date 8/13/99

C. Description of monument for corner and accessories established to perpetuate locating the position of the corner:

B-5: Set 5/8" x 36" roerod with Gladwin County Remonumentation Cap marked P.S.#27458 in Monument Box.

Witnesses:
 N02°E Large Stone with "x" 49.90'
 South Capped Iron 33.10'
 N40°E 6" Ash, nail & tag, 63.77'
 S15°E Power Pole, nail & tag, 143.40'
 N70°E 4" Poplar, nail & tag, 119.00'

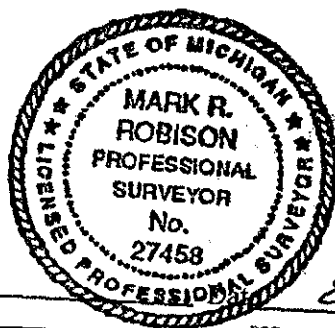

Signed by Mark R. Robison
 Surveyor's Michigan License No. 27458