

**SURVEY & REMONUMENTATION**

SEP 07 1999

**LAND CORNER RECORDATION CERTIFICATE**  
 Filing Requirement of Act 74, Mich. P.A. 1970  
 Gladwin County Remonumentation

**SECTION**

For Corners in  
GLADWIN  
 (County)

Located In: Corner Code#:  
 T. 17N R. 2W C-2  
 T. \_\_\_\_\_ R. \_\_\_\_\_  
 T. \_\_\_\_\_ R. \_\_\_\_\_  
 S. \_\_\_\_\_ T. \_\_\_\_\_ R. \_\_\_\_\_  
 S. \_\_\_\_\_ T. \_\_\_\_\_ R. \_\_\_\_\_  
 S. \_\_\_\_\_ T. \_\_\_\_\_ R. \_\_\_\_\_  
 S. \_\_\_\_\_ T. \_\_\_\_\_ R. \_\_\_\_\_

- 1. Public Land Survey
- 2. Public Controlling in Section
- 3. Miscellaneous Property in Section
- 4. Lot No. \_\_\_\_\_, Recorded Plat
- 5. Private Claims

LIBER 001 PAGE 254

STATE OF MICHIGAN  
 GLADWIN COUNTY  
 Filed-Remon

16 AUG 1999 2:31:38 PM

BONNIE K. HOUSE  
 REGISTER OF DEEDS

Register of Deeds Stamp & File Number

I, Mark R. Robison, in a field survey on May 3, 1999, do hereby certify that under requirements of P.A. 74, Michigan P.A. of 1970, the corner points mentioned in lines 1 and 2 above were in conformance with regulations and rules therefore as required in the current manual of survey instructions of the United States Department of the Interior, Bureau of Land Management or by a decree of a Court of Law and/or that the corner points mentioned in lines 3, 4 and 5 above were in conformance with the rules of the Michigan Board of Land Surveyors or by a Decree of a Court of Law, established, re-established, monumented, re-monumented, recovered, found as expressed below.

**NOTE: Not more than 2 corners, all in the same town and range, may be recorded on this certificate.**

	A	B	C	D	E	F	G	H	I	J	K	L	M
2	6	5	4	3	2	1							
3													
4	7	8	9	10	11	12							
5													
6	18	17	16	15	14	13							
7													
8	19	20	21	22	23	24							
9													
10	30	29	28	27	26	25							
11													
12	31	32	33	34	35	36							
13													

**A. Description of original monument and accessories and/or subsequent restoration:**

1850 William A. Burt  
 Sec QR, Section Post  
 Wit-(1) Elm 20 S62E 14  
 (2) B. Ash 10 S66W 17

1977 County Road Plans  
 Wit-none

1968 Lapham  
 Set Iron 5/8"  
 Wit-(3) P.P. N30E 120.25  
 (4) 4" Hickory ? N75W 31.60

1977 Sedgman LCRC#195,  
 survey & wkg dwg  
 Found 3/4" Bar  
 Wit-(5) N25E 120.64 Power Pole  
 (6) N50W 39.60 6" Hickory  
 (7) N75W 31.70 8" Hickory

1995 Wade Trim/Edmands Eng.  
 Road Construction  
 Found 1/2" rebar over capped iron  
 Wit-(8) S35E 90.97 to N&T in SW side  
 5" Ash  
 (9) S65W 31.78 to nail in North side  
 8" Ash (Hickory)  
 (10) N30E 120.50 to P.K. Nail  
 in U.P.  
 (11) N25W 57.7 to Nail in SW side  
 10" Elm

**B. Description of corner evidence found and/or method applied in restoring or re-establishing corner:**

Found monument box in centerline of road, no corner material in box. Monument box set in error by road contractor. Found P.K. Nail set by Edmands Engineering 0.5 feet East and 0.5 feet South of box. Agrees with witnesses (4), (7), (8) & (9). Also agrees with Edmands Engineering (1977) & (1995) and Sedgman (1977) measurements to C-1. Replaced found P.K. Nail with 5/8" rod, removed cover from monument box and filled box with cold patch (asphalt). See dossier for detailed report.


APPROVED LAND CORNER  
 P.A. 345 of 1990  
 Gladwin County

Co. Rep. [Signature]  
 Date 8/13/99

**C. Description of monument for corner and accessories established to perpetuate locating the position of the corner:**

C-2: Set 5/8" x 36" rod with Gladwin County Remonumentation cap marked P.S.#27458.

- Witnesses:
- N65°W 8" Ash, spike, 31.83'
  - S35°E 5" Ash, nail & tag, 90.80'
  - N25°E Power Pole, nail & tag, 118.79'
  - N30°W 10" Elm, spike, 57.68'
  - Mon. Box 0.5' North & 0.5' West of Corner

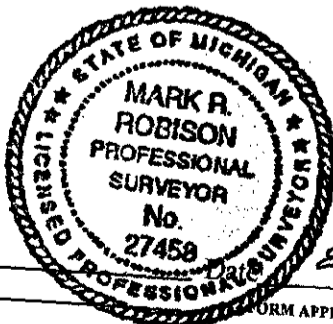

Signed by Mark R. Robison  
 Surveyor's Michigan License No. 27458