

SURVEY & REMONUMENTATION

SEP 07 1999

LAND CORNER RECORDATION CERTIFICATE
Filing Requirement of Act 74, Mich. P.A. 1970
Gladwin County Remonumentation

LIBER 001 PAGE 258

STATE OF MICHIGAN
 GLADWIN COUNTY
 Filed-Remon

16 AUG 1999 2:34:07 PM

BONNIE K. HOUSE
 REGISTER OF DEEDS

SECTION

For Corners in
GLADWIN
 (County)

Located In: Corner Code#:

- 1. Public Land Survey T. 17N R. 2W C-6
- 2. Public Controlling in Section S. ___ T. ___ R. ___
- 3. Miscellaneous Property in Section S. ___ T. ___ R. ___
- 4. Lot No. ___, Recorded Plat
- 5. Private Claims

Register of Deeds Stamp & File Number

I, Mark R. Robison, in a field survey on May 4, 1999, do hereby certify that under requirements of P.A. 74, Michigan P.A. of 1970, the corner points mentioned in lines 1 and 2 above were in conformance with regulations and rules therefore as required in the current manual of survey instructions of the United States Department of the Interior, Bureau of Land Management or by a decree of a Court of Law and/or that the corner points mentioned in lines 3, 4 and 5 above were in conformance with the rules of the Michigan Board of Land Surveyors or by a Decree of a Court of Law, established, re-established, monumented, re-monumented, recovered, found as expressed below.

NOTE: Not more than 2 corners, all in the same town and range, may be recorded on this certificate.

	A	B	C	D	E	F	G	H	I	J	K	L	M
1													
2	6	5	4	3	2	1							
3													
4	7	8	9	10	11	12							
5													
6	18	17	16	15	14	13							
7													
8	19	20	21	22	23	24							
9													
10	30	29	28	27	26	25							
11													
12	31	32	33	34	35	36							
13													

A. Description of original monument and accessories and/or subsequent restoration:

1850 William A. Burt
 Hemlock 4 QR. Section Cor
 Wit-(1)W. Pine 15 S67W 15

1979 Lapham
 survey & wkg dwg
 Set Nail
 Wit-(4)West, 35.65' - Corner Post.
 (5)East, 32.70' - Corner Post.
 (6)N40E, 61.65' - Post.

1908 CSR Set Crow Bar
 Wit-none

1972 Edmands Eng. county road plan
 Wit-(2)Fe. Cor. W 31.0
 (3)Fe. Cor E 31.3

1989 Lapham survey
 Found Spike in Centerline
 Wit-(7)West Fe. Post 35.95
 (8)East Fe. Post 32.90

B. Description of corner evidence found and/or method applied in restoring or re-establishing corner:

Found P.K. Nail in centerline North-South road, opposite fence East-West.
 Agrees with witnesses (4), (5) & (6). Accepted P.K. Nail and set 5/8" rod.

See dossier for detailed report.


APPROVED LAND CORNER
 P.A. 345 of 1990
 Gladwin County

Co. Rep. John Meyers
 Date 8/13/99

C. Description of monument for corner and accessories established to perpetuate locating the position of the corner:

C-6: Set 5/8" x 18" rered with Gladwin County Remonumentation cap marked P.S.#27458 in Monument Box.

- Witnesses:
 West Cor. Post, spike, 35.65'
 East Cor. Post, spike, 32.60'
 N40°E Fence Post, spike, 61.60'
 S80°W 4" Ash, nail & tag, 138.82'
 S45°W 4" Ash, nail & tag, 133.95'

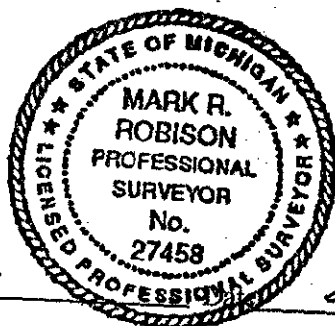

Signed by Mark R. Robison
 Surveyor's Michigan License No. 27458