

**SURVEY &
REMONUMENTATION**

SEP 07 1999

LAND CORNER RECORDATION CERTIFICATE
Filing Requirement of Act 74, Mich. P.A. 1970
Gladwin County Remonumentation

SECTION

LIBER 001 PAGE 261

For Corners in
GLADWIN
(County)

Located In: Corner Code#:

- 1. Public Land Survey T. 17N R. 2W C-9
T. _____ R. _____
T. _____ R. _____
- 2. Public Controlling S. _____ T. _____ R. _____
in Section S. _____ T. _____ R. _____
- 3. Miscellaneous S. _____ T. _____ R. _____
Property in Section S. _____ T. _____ R. _____
- 4. Lot No. _____, Recorded Plat _____
- 5. Private Claims _____

STATE OF MICHIGAN
GLADWIN COUNTY
Filed-Remon

16 AUG 1999 2:34:32 PM

BONNIE K. HOUSE
REGISTER OF DEEDS

Register of Deeds Stamp & File Number

I, Mark R. Robison, in a field survey on March 26, 1999, do hereby certify that under requirements of P.A. 74, Michigan P.A. of 1970, the corner points mentioned in lines 1 and 2 above were in conformance with regulations and rules therefore as required in the current manual of survey instructions of the United States Department of the Interior, Bureau of Land Management or by a decree of a Court of Law and/or that the corner points mentioned in lines 3, 4 and 5 above were in conformance with the rules of the Michigan Board of Land Surveyors or by a Decree of a Court of Law, established, re-established, monumented, re-monumented, recovered, found as expressed below.

NOTE: Not more than 2 corners, all in the same town and range, may be recorded on this certificate.

1	A	B	C	D	E	F	G	H	I	J	K	L	M
2	6	5	4	3	2	1							
3													
4	7	8	9	10	11	12							
5													
6	18	17	16	15	14	13							
7													
8	19	20	21	22	23	24							
9													
10	30	29	28	27	26	25							
11													
12	31	32	33	34	35	36							
13													

A. Description of original monument and accessories and/or subsequent restoration:

- 1850 William A. Burt 1977 Lapham LCRC#198
Sec Cor Post, Sec's 29, 30, 19 & 20 Wit-same as (3), (4) & (5)
- Wit-(1)W. Birch 10 S87E 5 1977 Lapham survey 1994 Lapham working dwg
(2)Cedar 10 S13W 36 Wit-same as (3), (4) & (5)
- 1972 Lapham field notes 1980 Lapham survey
Set 1/2" Bar Wit-same as (3), (4) & (5)
- Wit-(3)S50E 42.35 Fence Post, N&T 1989 Lapham
(4)N55E 79.72 P.P., N&T survey & working dwg
(5)N60E 42.82 Fence Post, N&T Wit-same as (3), (4) & (5)
- 1972 County Road Plan Edmands Eng.
Wit-(6)NW 75.48 T.P.
(7)NE 86.44 P.P.

B. Description of corner evidence found and/or method applied in restoring or re-establishing corner:

Found monument box, no corner material in box, in centerline of North-South road, centerline of road to East and 4 feet North of centerline of road to West. Set corner in center of box from witnesses (4) & (5). Agrees with Lapham and County Road Plans on measurement and procedure along the East line of Section 19.


See dossier for detailed report.

APPROVED LAND CORNER
P.A. 345 of 1990
Gladwin County
Co. Rep. [Signature]
Date 8/13/99

C. Description of monument for corner and accessories established to perpetuate locating the position of the corner:

C-9: Set 5/8" x 36" rerod with Gladwin County Remonumentation cap marked P.S.#27458 in existing Monument Box.

- Witnesses:
N55°E P.P., nail & tag, 79.72' (OBT)
N60°E Cor. Post, nail & tag, 42.50' (OBT)
N85°W 6" Ash, nail & tag, 57.80'
S55°W 8" Ash, nail & tag, 61.08'
S35°W 3" Ash, nail & tag, 90.79'

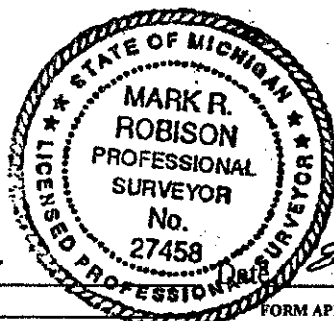

Signed by Mark R. Robison
Surveyor's Michigan License No. 27458