

SURVEY & REMONUMENTATION

SEP 07 1999

LAND CORNER RECORDATION CERTIFICATE
Filing Requirement of Act 74, Mich. P.A. 1970
Gladwin County Remonumentation

LIBER: **001** PAGE **262**

SECTION

For Corners in
GLADWIN

(County)

Located In:

Corner Code#:

- 1. Public Land Survey T. 17N R. 2W C-10
- T. _____ R. _____
- T. _____ R. _____
- 2. Public Controlling S. _____ T. _____ R. _____
in Section S. _____ T. _____ R. _____
- 3. Miscellaneous S. _____ T. _____ R. _____
Property in Section S. _____ T. _____ R. _____
- 4. Lot No. _____, Recorded Plat _____
- 5. Private Claims _____

STATE OF MICHIGAN
GLADWIN COUNTY

Filed-Remon

16 AUG 1999 2:34:41 PM

RONNIE K. HOUSE
REGISTER OF DEEDS

Register of Deeds Stamp & File Number

I, Mark R. Robison, in a field survey on March 31, 1999, do hereby certify that under requirements of P.A. 74, Michigan P.A. of 1970, the corner points mentioned in lines 1 and 2 above were in conformance with regulations and rules therefore as required in the current manual of survey instructions of the United States Department of the Interior, Bureau of Land Management or by a decree of a Court of Law and/or that the corner points mentioned in lines 3, 4 and 5 above were in conformance with the rules of the Michigan Board of Land Surveyors or by a Decree of a Court of Law, established, re-established, monumented, re-monumented, recovered, found as expressed below.

NOTE: Not more than 2 corners, all in the same town and range, may be recorded on this certificate.

	A	B	C	D	E	F	G	H	I	J	K	L	M
2	6	5	4	3	2	1							
3													
4	7	8	9	10	11	12							
5													
6	18	17	16	15	14	13							
7													
8	19	20	21	22	23	24							
9													
10	30	29	28	27	26	25							
11													
12	31	32	33	34	35	36							
13													

A. Description of original monument and accessories and/or subsequent restoration:

1850 William A. Burt
Set QR. Section Post
Wit-(1) Cedar 8 N81 W 23
(2) Do 20 S87 E 35

1970 County Road Plans Edmands Eng.
1/2" Iron
Wit-(3) Nail in Fence 25.0
(4) Nail in Fence 31.0

1972 Lapham survey,
work dwg, LCRC#32A
Set 1/2" Bar
Wit-(5) East 38.38 Fe. Post, N&T
(6) West 41.15 Fence Post, N&T
(7) N35E 148.17 Power Pole, N&T

1989 Lapham working dwg

1977 Lapham survey
Found 1/2" Bar
Wit-(8) S50E, 42.35' - Fe. Post
(9) N55E, 79.72' - P.P.
(10) N60E, 42.82' - Fence Post

B. Description of corner evidence found and/or method applied in restoring or re-establishing corner:

Found 1/2" Iron in monument box in centerline North-South road opposite fences East & West. No other corner found. Found witnesses: (5) Meas. 38.52', Rec. 38.38'; (6) Meas. 41.20', Rec. 41.15'. Agrees with Lapham and Edmands Engineering measurements to C-9 and C-11. Replaced found 1/2" Iron with 5/8" x 36" rerod.

See dossier for detailed report.


APPROVED LAND CORNER
P.A. 345 of 1990
Gladwin County

Co. Rep. [Signature]
Date 8/13/99

C. Description of monument for corner and accessories established to perpetuate locating the position of the corner:

C-10: Set 5/8" x 36" rerod with Gladwin County Remonumentation cap marked P.S.#27458 in Monument Box.

Witnesses:
S45°E 6" J. Pine, nail & tag, 68.52'
East 6" Ash, nail & tag, 67.10'
S45°W 8" W. Pine, nail & tag, 70.13'
West 6" Ash, nail & tag, 78.04'

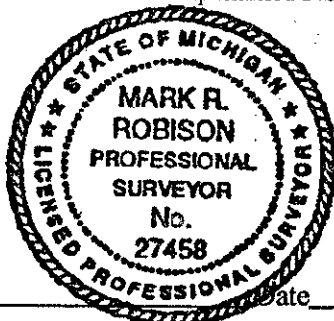

Signed by Mark R. Robison
Surveyor's Michigan License No. 27458

Date 8-10-99