

**SURVEY &  
REMONUMENTATION**

JAN 17 1996

**LAND CORNER RECORDATION CERTIFICATE**  
Filing Requirement of Act 74, Mich. P.A. 1970

LIBER 001 PAGE 101

STATE OF MICHIGAN  
GLADWIN COUNTY  
FILED-REMONUMENTATION

26 DEC 95 10:57 A.M.

BONNIE K. HOUSE  
REGISTER OF DEEDS

For corners in **COMMISSION**

GLADWIN (County)	Located In:	Corner Code #
1. Public Land Survey	T 17NR 2W	E-13
	T R	
	T R	
	T R	
2. Property Controlling in Section	S T R	
	S T R	
3. Miscellaneous Property in Sec.	S T R	
	S T R	

Register of Deeds Stamp & File Number

4. Lot No. \_\_\_\_\_, Recorded Plat \_\_\_\_\_  
5. Private Claims \_\_\_\_\_

I, **PAUL B. LAPHAM**, in a field survey on **MAY-NOVEMBER 19 95** do hereby state that under requirements of P.A. 74, Michigan P.A. of 1970, the corner points mentioned in lines 1 and 2 above were in conformance with regulations and rules therefore as required in the current manual of survey instructions of the United States Department of the Interior, Bureau of Land Management or by a decree of a Court of Law and for that the corner points mentioned in lines 3, 4 and 5 above were in conformance with the rules of the Michigan Board of Land Surveyors or by a Decree of a Court of Law, established, re-established, monumented, recovered, found as expressed below:

NOTE: Not more than 2 corners, all in the same town and range, may be recorded on this certificate.

	A	B	C	D	E	F	G	H	I	J	K	L	M
1													
2	6		5		4		3		2		1		
3													
4	7		8		9		10		11		12		
5													
6	18		17		16		15		14		13		
7													
8	19		20		21		22		23		24		
9													
10	30		29		28		27		26		25		
11													
12	31		32		33		34		35		36		
13													

- A. Description of original monument and accessories and/or subsequent restoration:
- 1830 WILLIAM A BURT  
SET CORNER POST  
WIT.-(1)ELM 20" N47°E 8  
(2)B. ASH 6" N87°W 18
  - 1950 EDMUND  
WITNESSES SHEET  
WIT.-(3)P.P. N.E. 84.5'  
(4)P.P. S.E. 140.78'  
(5)UTILITY POLE N.W. 82.7'
  - 1974 LAPHAM  
FIELD NOTES & WORKING DWG.  
FOUND 1/2" IRON
  - 1991 LAPHAM UNRECORDED L.C.R.C.  
FOR COUNTY ROAD CONSTRUCTION  
FOUND 1/2" ROD  
WIT.-(6)N20°W 18" MAPLE 62.85'  
(7)N45°W POWER POLE 85.05'  
(8)S45°E POWER POLE 67.95'  
(9)EAST 1 1/4" PIPE 88.70'

APPROVED LAND CORNER  
P.A. 345 of 1990  
Gladwin County

Co. Rep. *J. H. Meyer*  
Date 12/18/95


- B. Description of corner evidence found and/or method applied in restoring or reestablishing corner:
- FOUND 1/2"x18" THREADED BOLT WITH SQUARE NUTS ON BOTH ENDS, AT INTERSECTION CENTER LINE EXTENDED EXCAVATED FOUND NO OTHER CORNERS, SET GLADWIN RE-MON FROM WITNESSES (6), (8), & (9) AND FOUND CORNER.

This Corner established in Gladwin County Remonumentation Program.  
See dossier for detailed report.

- C. Description of monument for corner and accessories established to perpetuate locating the position of the corner:

E-13: 32-33 SECTION CORNER ON TOWNSHIP LINE  
SET 5/8"x36" RE-ROD WITH GLADWIN COUNTY RE-MON CAP, MARKED P.S. #9433.

- WITNESSES:  
N20°W 62.85' - NAIL & TAG IN 18" MAPLE  
N45°W 85.10' - NAIL & TAG IN POWER POLE  
N40°E 68.00' - NAIL & TAG IN POWER POLE  
EAST 88.70' - 1 1/4" PIPE - CLOSING CORNER REC. 88.44'

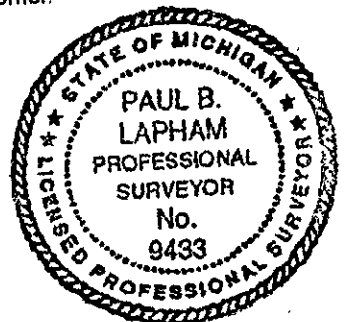

Signed by *Paul B. Lapham*  
Surveyor's Michigan License No. 9433

Date 12-22-95