

AUG 23 2000

SECTION

LAND CORNER RECORDATION CERTIFICATE
Filing Requirement of Act 74, Mich. P.A. 1970
Gladwin County Remonumentation

LIBER 001 PAGE 307

For Corners in

GLADWIN

(County)

Located In:

Corner Code#:

- 1. Public Land Survey T. 17N R. 2W F-3
2. Public Controlling in Section S. T. R.
3. Miscellaneous Property in Section S. T. R.
4. Lot No. Recorded Plat
5. Private Claims

STATE OF MICHIGAN
GLADWIN COUNTY
FILED-REMONUMENTATION

10 AUG 2000 11:20:05 AM

BONNIE K. HOUSE
REGISTER OF DEEDS

Register of Deeds Stamp & File Number

I, Mark R. Robison, in a field survey on April 2000, do hereby certify that under requirements of P.A. 74, Michigan P.A. of 1970, the corner points mentioned in lines 1 and 2 above were in conformance with regulations and rules therefore as required in the current manual of survey instructions of the United States Department of the Interior, Bureau of Land Management or by a decree of a Court of Law and/or that the corner points mentioned in lines 3, 4 and 5 above were in conformance with the rules of the Michigan Board of Land Surveyors or by a Decree of a Court of Law, established, re-established, monumented, re-monumented, recovered, found as expressed below.

Grid table with columns A-M and rows 1-13. A dot is present in cell G3.

NOTE: Not more than 2 corners, all in the same town and range, may be recorded on this certificate.

A. Description of original monument and accessories and/or subsequent restoration:

1850 William B. Burt--Set QR. Post
Wit-(1)Maple 10 S27E 42
(2)DO 12 N8E 55

1977 Lapham--working dwg

1971 Lapham--wkg dwg & witnesses
Fd bolt 2' deep, raised w/ 5/8" x 18" Iron
Wit-(3)South Cor Post 25.8
(4)N70E P.P. 169.95
(5)N65W 56.6 --
(6)S15W 3" Ash 42.6'

1979 Lapham--2 surveys & LCRC#227
Found 5/8" Iron Rod
Wit-(7)North Fence Cor. 51.55'
(8)South Fence Cor. 26.13'
(9)S45E Fence Post 42.00'
(10)S45W Poplar 48.25'

1992 Lapham--survey
Wit-same as (7), (8), (9)

1996 Lapham--survey, wkg dwg
Wit-same as (7), (8), (9)

B. Description of corner evidence found and/or method applied in restoring or re-establishing corner:

Found 1" x 14" black pipe 2 feet North of centerline East-West road opposite vintage fences North-South. Found witnesses (4)Recorded 169.95', measured 169.85'--set nail & tag in old blaze & (10)Recorded 48.25', measured 48.20'--set nail & tag over old blaze & reaction. Corner agrees with Lapham measurements to G-3 (1971) 2650.47' & (1998) 2650.50'. Accepted found black pipe as corner of record; replaced with 5/8" x 36" rerod.

APPROVED LAND CORNER
P.A. 345 of 1990
Gladwin County

See dossier for detailed report on corner F-3.


Co. Rep. [Signature]
Date 8-2-00

C. Description of monument for corner and accessories established to perpetuate locating the position of the corner:

Set 5/8" x 36" rerod with Gladwin Remonumentation cap marked P.S. 27458. Accepted as best available evidence to perpetuate position of corner F-3.

Witnesses:

- N20°E Power pole, nail & tag, 169.85' (OBT)
S45°W 10" Poplar, nail & tag, 48.20' (OBT)
S25°E 5" Oak, nail & tag, 99.25'
S25°W 5" Ash, nail & tag, 58.75'

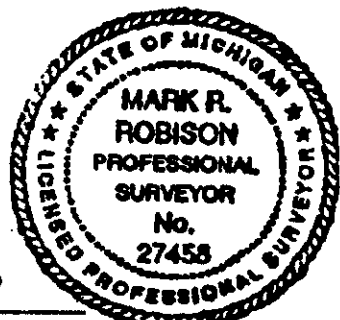

Signed by [Signature]
Surveyor's Michigan License No. 27458

Date 8-9-00