

SURVEY & REMONUMENTATION

SEP 07 1999

LAND CORNER RECORDATION CERTIFICATE
Filing Requirement of Act 74, Mich. P.A. 1970
Gladwin County Remonumentation

LIBER: **001** PAGE: **269**

SECTION

STATE OF MICHIGAN
 GLADWIN COUNTY

Filed-Remon

For Corners in
GLADWIN

16 AUG 1999 2:35:45 PM

BONNIE K. HOUSE
 REGISTER OF DEEDS

(County)	Located In:	Corner Code#:
1. Public Land Survey	T. <u>17N</u> R. <u>2W</u>	<u>F-5</u>
	T. _____ R. _____	_____
	T. _____ R. _____	_____
2. Public Controlling in Section	S. _____ T. _____ R. _____	_____
	S. _____ T. _____ R. _____	_____
3. Miscellaneous Property in Section	S. _____ T. _____ R. _____	_____
	S. _____ T. _____ R. _____	_____
4. Lot No. _____, Recorded Plat _____		
5. Private Claims _____		

Register of Deeds Stamp & File Number

I, Mark R. Robison, in a field survey on May 4, 1999, do hereby certify that under requirements of P.A. 74, Michigan P.A. of 1970, the corner points mentioned in lines 1 and 2 above were in conformance with regulations and rules therefore as required in the current manual of survey instructions of the United States Department of the Interior, Bureau of Land Management or by a decree of a Court of Law and/or that the corner points mentioned in lines 3, 4 and 5 above were in conformance with the rules of the Michigan Board of Land Surveyors or by a Decree of a Court of Law, established, re-established, monumented, re-monumented, recovered, found as expressed below.

NOTE: Not more than 2 corners, all in the same town and range, may be recorded on this certificate.

	A	B	C	D	E	F	G	H	I	J	K	L	M
1													
2	6	5	4	3	2	1							
3													
4	7	8	9	10	11	12							
5													
6	18	17	16	15	14	13							
7													
8	19	20	21	22	23	24							
9													
10	30	29	28	27	26	25							
11													
12	31	32	33	34	35	36							
13													

A. Description of original monument and accessories and/or subsequent restoration:

1850 William A. Burt
 Set QR. Section Post
 Wit-(1) Cedar 6 N1W 28
 (2) Fir 9 S70E 25

1976 Fluharty LCRC#138
 Set 5/8" x 18" rered from
 county road plan
 Wit-(7)S. End Conc. Tube, S20W, 24.70'
 (8)N. End Conc. Tube, N20W 27.28'
 (9)Fence Post, N30E, 38.23'

1994 Lapham wkg dwg
 Wit-none

1951 McCartney county road plans
 Set 1/2" Rod over Fd WD. Stake &
 Stone
 Wit-(3)N40W 37.40 T.P.
 (4)S35W 78.30 P.P.
 (5)Fe. Cor. N 26
 (6)Fe. Cor. S 26

1977 Lapham survey & wkg dwg
 Found 5/8" Rod
 Wit-same as (7), (8) & (9)

1996 Lapham 2 surveys
 Wit-same as (7), (8) & (9)

B. Description of corner evidence found and/or method applied in restoring or re-establishing corner:

Found 5/8" x 18" rered in centerline of road opposite survey line to North and field line to South. Agrees with witnesses (7) & (8). Survey line North agrees with 1951 county road plans and Lapham (1994) measurements to E-5 & G-5.

See dossier for detailed report.


APPROVED LAND CORNER
P.A. 345 of 1990
Gladwin County

Co. Rep. [Signature]
 Date 8/13/99

C. Description of monument for corner and accessories established to perpetuate locating the position of the corner:

F-5: Set 5/8" x 36" rered with Gladwin County Remonumentation cap marked P.S.#27458 in Monument Box.

Witnesses:
 S45°W Power Pole, nail & tag, 79.60'
 N45°E 3" W. Pine, nail & tag, 82.75'
 N5°W 18" Maple, nail & tag, 54.4'
 N50°W Cluster Maples, nail & tag, 93.80'
 North C.I. 33.00'

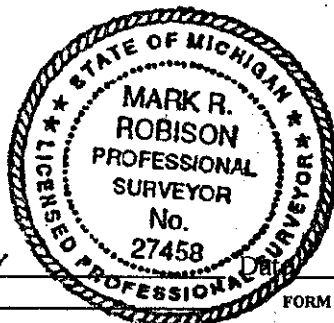

Signed by Mark R. Robison
 Surveyor's Michigan License No. 27458