

SURVEY & REMONUMENTATION

SEP 07 1999

LAND CORNER RECORDATION CERTIFICATE
Filing Requirement of Act 74, Mich. P.A. 1970
Gladwin County Remonumentation

LIBER 001 PAGE 270

SECTION

STATE OF MICHIGAN
 GLADWIN COUNTY
 Filed Remon

For Corners in
GLADWIN
 (County)

Located In: Corner Code#:

- 1. Public Land Survey T. 17N R. 2W G-5
 T. _____ R. _____
 T. _____ R. _____
- 2. Public Controlling S. _____ T. _____ R. _____
 in Section S. _____ T. _____ R. _____
- 3. Miscellaneous S. _____ T. _____ R. _____
 Property in Section S. _____ T. _____ R. _____
- 4. Lot No. _____, Recorded Plat _____
- 5. Private Claims _____

16 AUG 1999 2:35:55 PM

BONNIE K. HOUSE
 REGISTER OF DEEDS

Register of Deeds Stamp & File Number

I, Mark R. Robison, in a field survey on March 27, 1999, do hereby certify that under requirements of P.A. 74, Michigan P.A. of 1970, the corner points mentioned in lines 1 and 2 above were in conformance with regulations and rules therefore as required in the current manual of survey instructions of the United States Department of the Interior, Bureau of Land Management or by a decree of a Court of Law and/or that the corner points mentioned in lines 3, 4 and 5 above were in conformance with the rules of the Michigan Board of Land Surveyors or by a Decree of a Court of Law, established, re-established, monumented, re-monumented, recovered, found as expressed below.

	A	B	C	D	E	F	G	H	I	J	K	L	M
1													
2	6	5	4	3	2	1							
3													
4	7	8	9	10	11	12							
5													
6	18	17	16	15	14	13							
7													
8	19	20	21	22	23	24							
9													
10	30	29	28	27	26	25							
11													
12	31	32	33	34	35	36							
13													

NOTE: Not more than 2 corners, all in the same town and range, may be recorded on this certificate.

A. Description of original monument and accessories and/or subsequent restoration:

1850 William A. Burt
 Set Post Cor Sec's 9, 10, 15 & 16
 Wit-(1)Maple 13 N27E 27
 (2)Cedar 9 S54W 27

1970-84 Edmands Eng.
 Found P.K. nail and
 Found C.I.#18223 1.30 S &
 0.3 E of P.K.

1989 Lapham survey & working dwg
 Found C.I.
 Wit-(14)SE Face Project Marker 44.50
 (15)SW Top Center West End Conc
 Pipe 33.25
 (16)S45W P.P. 85.75

1907 C.S.R. Cedar Stake
 Wit-(3)Maple 14 S7°30'E 78 lks

Wit (to P.K. Nail)-
 (7)SW 34.0 to W. End 30" Conc Pipe
 (8)SE to E. End 30" Conc Pipe 35.5
 (9)NE 40.0 to W. End Conc Culvert
 (10)SE 45.4 Face Conc Proj Marker

1993-1996 Lapham 4 surveys & working
 dwgs
 Wit-same as (14), (15) & (16)

1951 County Road Plans, McCartney
 Set 1/2" rod over fd WD. Stake & Stone
 Wit-(4)N44E 43.70 T.P.
 (5)S40W 84.72 P.P.
 (6)S20E 29.83 SE Cor of East
 Headwall

1976 Fluharty LCRC#138
 Set 5/8"x 18" reroed
 Wit-(11)P.P., S37W, 85.76'
 (12)T.P., N40E, 44.59'
 (13)Project Marker, S40E, 44.52'

B. Description of corner evidence found and/or method applied in restoring or re-establishing corner:

Found 5/8" x 18" reroed in monument box, intersection of East-West-South roads--agrees with witnesses (4) & (13). Agrees with measurements by Lapham (1977) & (1993) and Edmands Eng. (1970) to S 1/4 Corner of Section 10. Also agrees with measurements by Lapham (1977) & (1994) and County Road Plans (1951) to S 1/4 Corner of Section 9.

See dossier for detailed report.


APPROVED LAND CORNER
P.A. 345 of 1990
Gladwin County

Co. Rep. [Signature]
 Date 8/13/99

C. Description of monument for corner and accessories established to perpetuate locating the position of the corner:

G-5: Set 5/8" x 36" reroed with Gladwin County Remonumentation cap marked P.S.#27458 in existing Monument Box.

Witnesses:
 N05°E Twin 6" Basswood, nail & tag, 49.82'
 N55°W 6" Birch, nail & tag, 87.38'
 S45°W Power pole, nail & tag, 84.00'
 S65°E 4" W. Pine, nail & tag, 122.25'

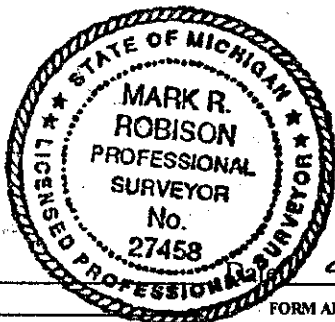

Signed by Mark R. Robison
 Surveyor's Michigan License No. 27458