

AUG 23 2000

SECTION

LAND CORNER RECORDATION CERTIFICATE
Filing Requirement of Act 74, Mich. P.A. 1970
Gladwin County Remonumentation

LIBER 001 PAGE 309

For Corners in
GLADWIN

(County)

Located In:

Corner Code#:

- 1. Public Land Survey T. 17N R. 2W H-3
2. Public Controlling in Section S. T. R.
3. Miscellaneous Property in Section S. T. R.
4. Lot No., Recorded Plat
5. Private Claims

STATE OF MICHIGAN
GLADWIN COUNTY
FILED-REMONUMENTATION

10 AUG 2000 11:20:28 AM

BONNIE K. HOUSE
REGISTER OF DEEDS

Register of Deeds Stamp & File Number

I, Mark R. Robison, in a field survey on April 2000, do hereby certify that under requirements of P.A. 74, Michigan P.A. of 1970, the corner points mentioned in lines 1 and 2 above were in conformance with regulations and rules therefore as required in the current manual of survey instructions of the United States Department of the Interior, Bureau of Land Management or by a decree of a Court of Law and/or that the corner points mentioned in lines 3, 4 and 5 above were in conformance with the rules of the Michigan Board of Land Surveyors or by a Decree of a Court of Law, established, re-established, monumented, re-monumented, recovered, found as expressed below.

NOTE: Not more than 2 corners, all in the same town and range, may be recorded on this certificate.

Grid table with columns A-M and rows 1-13. Cell (3, G) contains a black dot.

A. Description of original monument and accessories and/or subsequent restoration:

1850 William B. Burt
Set QR. Section Post
Wit-(1)Maple 8 S58 1/2W 14
(2)W. Pine 20 N7E 39

1976 Lapham
Field notes & working drawing
Set corner M.P.O.L.
Wit-none

1983-1987 Lapham
LCRC#283 & 2 surveys
Found Iron
Wit-(3)N40°W Power Pole, 56.6
(4)N70°W 20" Oak 67.29
(5)South Corner Post 29.24

B. Description of corner evidence found and/or method applied in restoring or re-establishing corner:

Found 1/2" x 18" rerod in centerline East-West road 3 feet West of fence to South (old corner post moved, tie to new post, fence to South irregular). Found witness (3)Recorded 56.60', measured 56.55'. Corner agrees with Lapham measurements in 1976 & 1983 as M.P.O.L. Accepted found 1/2" rerod as corner of record; replaced with 5/8" x 36" rerod.

See dossier for detailed report on corner H-3.


APPROVED LAND CORNER
P.A. 345 of 1990
Gladwin County

Co. Rep. [Signature]
Date 8-2-00

C. Description of monument for corner and accessories established to perpetuate locating the position of the corner:

Set 5/8" x 36" rerod with Gladwin Remonumentation cap marked P.S. 27458. Accepted as best available evidence to perpetuate position of corner H-3.

Witnesses:
N40°W Power Pole, nail & tag, 56.55' (OBT)
North 14" W. Pine, nail & tag, 79.41'
South 10" Ash, nail & tag, 68.43'
S42°W 6" Ash, nail & tag, 77.62'

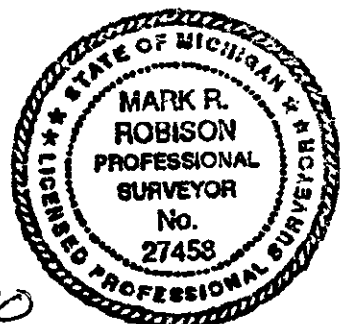

Signed by [Signature]
Surveyor's Michigan License No. 27458

Date 8-9-00