

SURVEY & REMONUMENTATION

SEP 07 1999

LAND CORNER RECORDATION CERTIFICATE
 Filing Requirement of Act 74, Mich. P.A. 1970
 Gladwin County Remonumentation

LIBER 001 PAGE 271

SECTION

For Corners in
GLADWIN
 (County)

	Located In:	Corner Code#:
1. Public Land Survey	T. <u>17N</u> R. <u>2W</u>	<u>H-5</u>
	T. _____ R. _____	_____
	T. _____ R. _____	_____
2. Public Controlling in Section	S. _____ T. _____ R. _____	_____
	S. _____ T. _____ R. _____	_____
3. Miscellaneous Property in Section	S. _____ T. _____ R. _____	_____
	S. _____ T. _____ R. _____	_____
4. Lot No. _____, Recorded Plat _____		
5. Private Claims		

STATE OF MICHIGAN
 GLADWIN COUNTY
 Filed-Remon

16 AUG 1999 2:36:03 PM

BONNIE K. HOUSE
 REGISTER OF DEEDS

Register of Deeds Stamp & File Number

I, Mark R. Robison, in a field survey on March 27, 1999, do hereby certify that under requirements of P.A. 74, Michigan P.A. of 1970, the corner points mentioned in lines 1 and 2 above were in conformance with regulations and rules therefore as required in the current manual of survey instructions of the United States Department of the Interior, Bureau of Land Management or by a decree of a Court of Law and/or that the corner points mentioned in lines 3, 4 and 5 above were in conformance with the rules of the Michigan Board of Land Surveyors or by a Decree of a Court of Law, established, re-established, monumented, re-monumented, recovered, found as expressed below.

NOTE: Not more than 2 corners, all in the same town and range, may be recorded on this certificate.

	A	B	C	D	E	F	G	H	I	J	K	L	M
1													
2	6	5	4	3	2	1							
3													
4	7	8	9	10	11	12							
5													
6	18	17	16	15	14	13							
7													
8	19	20	21	22	23	24							
9													
10	30	29	28	27	26	25							
11													
12	31	32	33	34	35	36							
13													

A. Description of original monument and accessories and/or subsequent restoration:

1850 William A. Burt
 Set QR. Section Post
 Wit-(1)Maple 16 N30E 41
 (2)Y. Birch 22 S55W 17

1977 Lapham working dwg.
 1987 Lapham working dwg.

1977 Edmands Eng
 3 surveys & LCRC#167
 Set P.K. Nail, 3' North of C/L
 Wit-(3)South 33.85 Face T. Pole
 (4)Northeast 59.35 Face T. Pole
 (5)Southeast 40.2 Face E Gate Post

1989 Lapham survey
 Found P.K. Nail
 Wit-same as (3), (4) & (5)
 1993 Lapham survey G-934000
 Found P.K. nail
 Wit-same as (3), (4) & (5)

B. Description of corner evidence found and/or method applied in restoring or re-establishing corner:

Found monument box, no corner found, 3 feet North of centerline of East-West road opposite survey lines North & South, opposite fence to South, 6 feet West of fence to North. Found (4) and Found C.I. to North. Agrees with monument box location. Reset corner from Lapham survey#934000.


See dossier for detailed report.

C. Description of monument for corner and accessories established to perpetuate locating the position of the corner:

Witnesses:
 Northeast P.P. (Face) 59.90'
 S25°E Power Pole, nail & tag, 73.04'
 S10°W 4" W. Pine, nail & tag, 86.40'
 N60°E 4" W. Pine, nail & tag, 66.65'
 North, C.I., 33.00'
 South, C.I., 32.59'

APPROVED LAND CORNER
 P.A. 245 of 1990
 Gladwin County

Co. Rep. J. L. Meyers
 Date 8/13/99

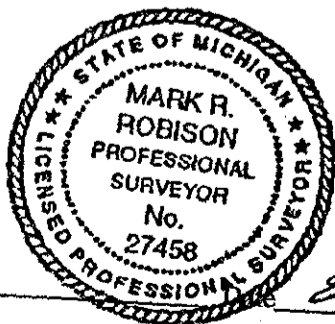

Signed by Mark R. Robison
 Surveyor's Michigan License No. 27458