

**SURVEY &
REMONUMENTATION**

SEP 07 1999 LAND CORNER RECORDATION CERTIFICATE
Filing Requirement of Act 74, Mich. P.A. 1970
Gladwin County Remonumentation

SECTION

LIBER 001 PAGE 272

For Corners in
GLADWIN
 (County)

Located In: Corner Code#:

- 1. Public Land Survey T. 17N R. 2W I-4
- 2. Public Controlling S. T. R. in Section
- 3. Miscellaneous S. T. R. Property in Section
- 4. Lot No. , Recorded Plat
- 5. Private Claims

STATE OF MICHIGAN
 GLADWIN COUNTY
 Filed Remon

16 AUG 1999 2:36:12 PM

BONNIE K. HOUSE
 REGISTER OF DEEDS

Register of Deeds Stamp & File Number

I, Mark R. Robison, in a field survey on March 26, 1999, do hereby certify that under requirements of P.A. 74, Michigan P.A. of 1970, the corner points mentioned in lines 1 and 2 above were in conformance with regulations and rules therefore as required in the current manual of survey instructions of the United States Department of the Interior, Bureau of Land Management or by a decree of a Court of Law and/or that the corner points mentioned in lines 3, 4 and 5 above were in conformance with the rules of the Michigan Board of Land Surveyors or by a Decree of a Court of Law, established, re-established, monumented, re-monumented, recovered, found as expressed below.

NOTE: Not more than 2 corners, all in the same town and range, may be recorded on this certificate.

| | | | | | | | | | | | | | |
|----|----|----|----|----|----|----|---|---|---|---|---|---|---|
| 1 | A | B | C | D | E | F | G | H | I | J | K | L | M |
| 2 | 6 | 5 | 4 | 3 | 2 | 1 | | | | | | | |
| 3 | | | | | | | | | | | | | |
| 4 | 7 | 8 | 9 | 10 | 11 | 12 | | | | | | | |
| 5 | | | | | | | | | | | | | |
| 6 | 18 | 17 | 16 | 15 | 14 | 13 | | | | | | | |
| 7 | | | | | | | | | | | | | |
| 8 | 19 | 20 | 21 | 22 | 23 | 24 | | | | | | | |
| 9 | | | | | | | | | | | | | |
| 10 | 30 | 29 | 28 | 27 | 26 | 25 | | | | | | | |
| 11 | | | | | | | | | | | | | |
| 12 | 31 | 32 | 33 | 34 | 35 | 36 | | | | | | | |
| 13 | | | | | | | | | | | | | |

A. Description of original monument and accessories and/or subsequent restoration:

- 1850 William A. Burt Set QR. Sec Post Wit-(1) Cedar 14 S51W 21 (2) Maple 24 N69E 42
- 1974 Lapham LCRC#78 Found Capped "T" Bar Wit-(6) N34W, 81.44' - P.P. (7) N86W, 33.37' - Cor Fe Post (8) S46W, 47.98' - T.P.
- 1964 County Road Plans Found T-Iron Wit-(3) West 33.1 Cor. Post (4) S45W 49.35 T.P. (5) N43E 43.60 Cor. Post
- 1983-1998 Lapham 3 surveys & working dwgs Wit-same as (6), (7) & (8)

B. Description of corner evidence found and/or method applied in restoring or re-establishing corner:

Found T-Bar opposite fence to West, 6 feet South of centerline road to East extended. Agrees with witnesses (6) & (7). Replaced T-Bar with 5/8" x 36" rerod.

See dossier for detailed report.


APPROVED LAND CORNER
 P.A. 845 of 1990
 Gladwin County

Co. Rep. [Signature]
 Date 8/13/99

C. Description of monument for corner and accessories established to perpetuate locating the position of the corner:

I-4: Set 5/8" x 36" rerod with Gladwin County Remonumentation cap marked P.S.#27458.

- Witnesses:
- S45°W Tele. Pole, spike & cap, 47.91' (OBT)
 - N34°W Power Pole, spike, 81.50' (OBT)
 - S20°E Power Pole, nail & tag, 121.00'
 - N40°E Power Pole, nail & tag, 73.58'
 - East, P.K. Nail in C/L road, 28.90'

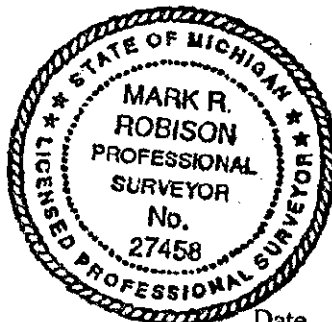

Signed by [Signature]
 Surveyor's Michigan License No. 27458

Date 8-10-99