

**SURVEY &
REMONUMENTATION**

JAN 17 1996

LAND CORNER RECORDATION CERTIFICATE
Filing Requirement of Act 74, Mich. P.A. 1970

LIBER **001** PAGE **98**

For corners in

COMMISSION

<u>GLADWIN</u> (County)	Located In:	Corner Code #
1. Public Land Survey	T <u>17NR 2W</u>	<u>K-8</u>
	T <u> </u> R <u> </u>	<u> </u>
	T <u> </u> R <u> </u>	<u> </u>
	T <u> </u> R <u> </u>	<u> </u>
2. Property Controlling in Section	S <u> </u> T <u> </u> R <u> </u>	<u> </u>
	S <u> </u> T <u> </u> R <u> </u>	<u> </u>
3. Miscellaneous Property in Sec.	S <u> </u> T <u> </u> R <u> </u>	<u> </u>
	S <u> </u> T <u> </u> R <u> </u>	<u> </u>

STATE OF MICHIGAN
GLADWIN COUNTY
FILED-REMONUMENTATION

26 DEC 95 10:56 A.M.

BONNIE K. HOUSE
REGISTER OF DEEDS

Register of Deeds Stamp & File Number

4. Lot No. _____, Recorded Plat _____
5. Private Claims _____

I, PAUL B. LAPHAM, in a field survey on MAY-NOVEMBER, 19 95 do hereby state that under requirements of P.A. 74, Michigan P.A. of 1970, the corner points mentioned in lines 1 and 2 above were in conformance with regulations and rules therefore as required in the current manual of survey instructions of the United States Department of the Interior, Bureau of Land Management or by a decree of a Court of Law and/or that the corner points mentioned in lines 3, 4 and 5 above were in conformance with the rules of the Michigan Board of Land Surveyors or by a Decree of a Court of Law; established, re-established, monumented, recovered, found as expressed below:

NOTE: Not more than 2 corners, all in the same town and range, may be recorded on this certificate.

A	B	C	D	E	F	G	H	I	J	K	L	M
1												
2	6		5		4		3		2		1	
3												
4	7		8		9		10		11		12	
5												
6	18		17		16		15		14		13	
7												
8	19		20		21		22		23		24	
9												
10	30		29		28		27		26		25	
11												
12	31		32		33		34		35		36	
13												

A. Description of original monument and accessories and/or subsequent restoration:

1830 WILLIAM A. BURT
SET POST
WIT.-(1)W. PINE 26" S63°W 8'
(2)W. PINE 18" N39°E 17'

1992 LAPHAM UNRECORDED L.C.R.C.
FOUND 1/2" IRON
WIT.-(5)POWER POLE N80°E 37.90'
(6)TOP CEN. 24' C.M.P. N&T, EAST 23.55'
(7)TOP CEN 24' C.M.P. N&T, S30°E 61.38'
(8)1/2" RE-ROD S85°W 56.20'

1991 LAPHAM SURVEY #G-911875
FOUND 1/2" IRON
WIT.-(3)S60°E 38.33' FENCE COR.
(4)N80°E 36.60' POWER POLE
(5)S80°W 33.60' POWER POLE

B. Description of corner evidence found and/or method applied in restoring or reestablishing corner:

SET COR. FROM WITNESSES, EXCAVATED FOUND 1/2"x18" RE-ROD 20" BELOW SURFACE OF ASPHALT ROAD, 1/4 OF DRAIN TO EAST, SET GLADWIN MON. IN POSITION OF FOUND IRON & WITNESSES (5), (6) & (7).

This Corner established in Gladwin County Remonumentation Program.

See dossier for detailed report.


C. Description of monument for corner and accessories established to perpetuate locating the position of the corner:

K-8: CORNER COMMON TO SECTIONS 23 & 24
SET 5/8"x36" RE-ROD WITH GLADWIN COUNTY RE-MON CAP, MARKED P.S. #9433 IN MON. BOX.

WITNESSES:
N80°E 37.90' - NAIL & TAG IN POWER POLE
EAST 23.55' - NAIL & TAG IN 24" C.M.P. TOP CENTER
S30°E 61.38' - NAIL & TAG IN 12" C.M.P. TOP CENTER
S85°W 37.07' - 5/8"x36" RE-ROD
NORTH P.K. NAIL 2.0'
EAST P.K. NAIL 2.0'

APPROVED LAND CORNER
P.A. 345 of 1990
Gladwin County

Co. Rep. J. H. McInnes
Date 12/18/95

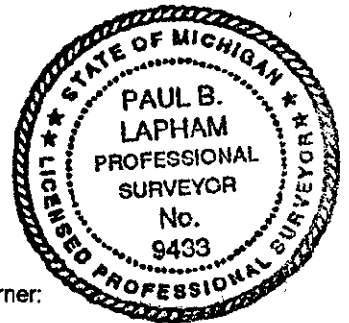

Signed by Paul B. Lapham
Surveyor's Michigan License No. 9433

Date 12-22-95