

SURVEY & REMONUMENTATION

DEC 01 1999

LAND CORNER RECORDATION CERTIFICATE
 Filing Requirement of Act 74, Mich. P.A. 1970
 Gladwin County Remonumentation

LIBER 001 PAGE 288

SECTION

For Corners in
GLADWIN

(County)

Located In:

Corner Code#:

- 1. Public Land Survey T. 17N R. 2W M-4
 T. _____ R. _____
 T. _____ R. _____
- 2. Public Controlling S. _____ T. _____ R. _____
 in Section S. _____ T. _____ R. _____
- 3. Miscellaneous S. _____ T. _____ R. _____
 Property in Section S. _____ T. _____ R. _____
- 4. Lot No. _____, Recorded Plat _____
- 5. Private Claims _____

STATE OF MICHIGAN
 GLADWIN COUNTY
 FILED-REMONUMENTATION

19 NOV 1999 2:05:31 PM

BONNIE K. HOUSE
 REGISTER OF DEEDS

Register of Deeds Stamp & File Number

I, Mark R. Robison, in a field survey on April 29, 1999, do hereby certify that under requirements of P.A. 74, Michigan P.A. of 1970, the corner points mentioned in lines 1 and 2 above were in conformance with regulations and rules therefore as required in the current manual of survey instructions of the United States Department of the Interior, Bureau of Land Management or by a decree of a Court of Law and/or that the corner points mentioned in lines 3, 4 and 5 above were in conformance with the rules of the Michigan Board of Land Surveyors or by a Decree of a Court of Law, established, re-established, monumented, re-monumented, recovered, found as expressed below.

NOTE: Not more than 2 corners, all in the same town and range, may be recorded on this certificate.

	A	B	C	D	E	F	G	H	I	J	K	L	M
1													
2		6	5	4	3	2	1						
3													
4	7	8	9	10	11	12							
5													
6	18	17	16	15	14	13							
7													
8	19	20	21	22	23	24							
9													
10	30	29	28	27	26	25							
11													
12	31	32	33	34	35	36							
13													

A. Description of original monument and accessories and/or subsequent restoration:

- Robert M. Clark Jr.
 Set 1/2 Mile Post
 Wit-(1)B. Ash 11 S23W 25
 (2)Sugar 10 N13W 13
 1893 Plat: Bliss, Brown & Ryan's
 Addition to Beaverton
 P.O.B 1/4 Corner
 1960-69 Edmands Eng.
 survey & working dwg
 Found Mon Box
- 1982-87 Lapham LCRC#32A
 surveys & working dwg
 Fd Bolt Spike in Mon Box
 Wit-(3)East 26.85' Power Pole
 (4)N20E 68.5' Power Pole
 (5)North 12.85' Monument Box
- 1931 MSHD Road Plans
 1 1/2" Gas Pipe - Boat Spike Above
 Common to Sec 12 & 7
 Wit-(6)S49°15W...43.7 15" Maple
 (7)N42°05W...66.4 to 5" Apple
 (8)N67°45E...59.9 to 24" Poplar

- 1998 MDOT
 Found Boat Spike in Mon Box
 Wit-(9)N20E 68.39' Nail w/Rusty Metal
 Cap in E. Side Power Pole
 (10)S50E 38.83' Chis "x" NW Bolt
 Sign Base
 (11)West 27.10' Nail w/MDOT tag
 in S. Side of Power Service &
 Light Anchor Pole
 (12)S25W 94.32' Nail w/MDOT tag
 in E. Side 40" Maple

B. Description of corner evidence found and/or method applied in restoring or re-establishing corner:

Found bolt spike in monument box 3.5 feet East of centerline of M-18, 25 feet South of centerline of road East. Agrees with witnesses (3), (4) & (5) and Plat of Bliss, Brown & Ryan's Addition to Beaverton, November 20, 1893. Also agrees with Edmands Engineering (1966) and Lapham (1982) measurements to M-5. Accepted bolt spike and replaced with 5/8" rod.

See dossier for detailed report.

APPROVED LAND CORNER
 P.A. 345 of 1990
 Gladwin County


Co. Rep. [Signature]
 Date July 28, 1999

C. Description of monument for corner and accessories established to perpetuate locating the position of the corner:

M-4: Set 5/8" x 36" rod with Gladwin County Remonumentation cap marked P.S.#27458 in Monument Box.

Witnesses:

- N20E Power Pole, nail & tag, 68.40' (MDOT)
- S50E Chis "x" NW Bolt Sign Base 38.83' (MDOT)
- West Utility Pole, nail & tag, 27.05' (MDOT)
- S25W 40" Maple, nail & tag, 94.32' (MDOT)
- N45E 10" Spruce, nail & tag, 102.35'
- N70W SE Cor Bldg., P.K., Nail, 62.76'
- S45W 36" Maple, nail & tag, 104.22'
- North, West 1/4 Corner, Section 7, T17N, R1W, 12.87'

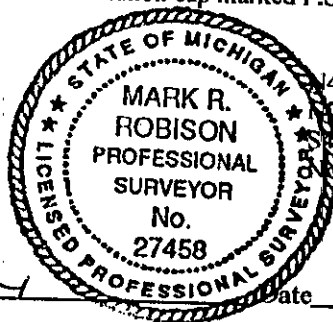

Signed by [Signature]
 Surveyor's Michigan License No. 27458

Date 11-16-99