

**SURVEY & REMONUMENTATION**  
**APR 07 1995**  
**COMMISSION**

**LAND CORNER RECORDATION CERTIFICATE**  
**Filing Requirement of Act 74, Mich. P.A. 1970**

For corners in

GLADWIN  
 (County)

Located in:

Corner Code #

- |                                    |                          |             |
|------------------------------------|--------------------------|-------------|
| 1. Public Land Survey              | T <u>18N</u> R <u>1E</u> | <u>F-13</u> |
|                                    | T _____ R _____          | _____       |
|                                    | T _____ R _____          | _____       |
|                                    | T _____ R _____          | _____       |
| 2. Property Controlling in Section | S _____ T _____ R _____  | _____       |
|                                    | S _____ T _____ R _____  | _____       |
| 3. Miscellaneous Property in Sec.  | S _____ T _____ R _____  | _____       |
|                                    | S _____ T _____ R _____  | _____       |

STATE OF MICHIGAN  
 GLADWIN COUNTY  
 RECORDED

28 DEC 94 3:00 P.M.

BONNIE K. HOUSE  
 REGISTER OF DEEDS

Register of Deeds Stamp & File Number

4. Lot No. \_\_\_\_\_, Recorded Plat \_\_\_\_\_  
 5. Private Claims \_\_\_\_\_

	A	B	C	D	E	F	G	H	I	J	K	L	M
2	6	5	4	3	2	1							
3													
4	7	8	9	10	11	12							
5													
6	18	17	16	15	14	13							
7													
8	19	20	21	22	23	24							
9													
10	30	29	28	27	26	25							
11													
12	31	32	33	34	35	36							
13													

I, PAUL B. LAPHAM, in a field survey on NOVEMBER, 19 94, do hereby certify that under requirements of P.A. 74, Michigan P.A. of 1970, the corner points mentioned in lines 1 and 2 above were in conformance with regulations and rules therefore as required in the current manual of survey instructions of the United States Department of the Interior, Bureau of Land Management or by a decree of a Court of Law and/or that the corner points mentioned in lines 3, 4 and 5 above were in conformance with the rules of the Michigan Board of Land Surveyors or by a Decree of a Court of Law; established, re-established, monumented, re-monumented, recovered, found as expressed below:

**NOTE: Not more than 4 corners, all in the same town and range, may be recorded on this certificate.**

A. Description of original monument and accessories and/or subsequent restoration:

1846 JOHN MULLITT,  
 SET 1/2" MILE POST  
 WIT.-PINE 36" N45°W 29 LKS.  
 HEMLOCK 12" N16°E 13 LKS.

1972 EDMAND, SURVEY

1977 LLOYD MCINNIS, L.C.R.C.  
 SET IRON  
 WIT.-N10°W 58.49' TO LARGEST TREE IN CLUMP

1986 LAPHAM, SURVEY & WORKSHEET  
 FOUND 3/8" IRON  
 WIT.-N10°W MAPLE 58.49'  
 N40°E 14" ASH 100.99'  
 N15°W POWER POLE 43.50'

1989 CASE, L.C.R.C. #324  
 FOUND 1/2" IRON  
 WIT.-S14°W 3" ELM 11.57'  
 N73°W MAILBOX POST 65.23'  
 N13°W POWER POLE 43.37'  
 N47°E 2" MAPLE 87.17', WEST-N 1/4 COR. SEC. 4, T17N, R1E 8.46'

B. Description of corner evidence found and/or method applied in restoring or reestablishing corner:

FOUND 3/8" RE-ROD 6" SOUTH CENTER LINE IN GRAVEL ROAD.  
 OLD DOWN FENCE NORTH, SEARCHED-FOUND NO OTHER CORNER EVIDENCE.  
 N13°W POWER POLE 43.37', MEAS. 43.34' - NAIL & TAG  
 WEST N 1/4 SEC. 4, T17N, R1E 8.46', MEAS. 8.46'  
 SET CORNER IN FOUND LOCATION OF 3/8" RE-ROD & WITNESSES.

**APPROVED LAND CORNER**  
 P.A. 345 of 1990  
 Gladwin County


Co. Rep. [Signature]  
 Date 12-19-94

Accepted as best available evidence of the position of the original corner & replaced with Standard Monument.

Corner, F-13 was approved for remonumentation at a Peer Review Committee Meeting on 12/19, 19 94.

C. Description of monument for corner and accessories established to perpetuate locating the position of the corner:

F-13: Corner common to Section 33  
 SET 5/8" x 36" RE-ROD WITH GLADWIN COUNTY RE-MON CAP, MARKED P.S. #9433.  
 N13°W POWER POLE - NAIL & TAG - 43.34'  
 WEST N 1/4 COR. SEC. 4, T17N, R1E, 8.46'  
 N45°E 8" OAK - NAIL & TAG - 126.85'  
 N40°E BASSWOOD - NAIL & TAG - 54.94'

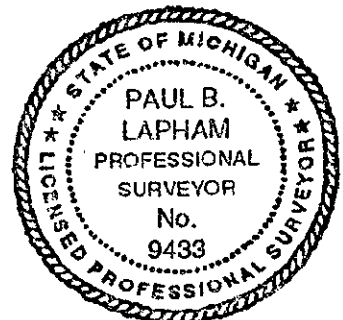

Signed by [Signature] Date 12-23-94  
 Surveyor's Michigan License No. 9433