

**SURVEY & REMONUMENTATION**

**OCT 23 1998**

GLADWIN County Remonumentation

**SECTION**

**LAND CORNER RECORDATION CERTIFICATE**  
Filing Requirement of Act 74, Mich. P.A. 1970

**LIBER 001 PAGE 231**

STATE OF MICHIGAN  
GLADWIN COUNTY  
FILED-CORNER

13 OCT 1998 12:48:25 PM

BONNIE K. HOUSE  
REGISTER OF DEEDS

Register of Deeds Stamp & File Number

For corners in

<u>GLADWIN</u> (County)	Located In:	Corner Code #
1. Public Land Survey	T18N R01E	M-4
	T R	
	T R	
	T R	
2. Property Controlling in Section	S T R	
	S T R	
3. Miscellaneous Property in Sec.	S T R	
	S T R	

4. Lot No. \_\_\_\_\_, Recorded Plat \_\_\_\_\_  
5. Private Claims \_\_\_\_\_

I, Mark R Robison, in a field survey on April \_\_\_\_\_, 1998, do hereby state that under requirements of P.A. 74, Michigan P.A. of 1970, the corner points mention in lines 1 and 2 above were in conformance with regulations and rules therefore as required in the current manual of survey instructions of the United States Department of the Interior, Bureau of Land Management or by a decree of a Court of Law and/or that the corner points mentioned in lines 3, 4 and 5 above were in conformance with the rules of the Michigan Board of Land Surveyors or by a Decree of a Court of Law; established, re-established, monumented, recovered, found as expressed below:

**NOTE: Not more than 2 corners, all in the same town and range, may be recorded on this certificate**

1	A	B	C	D	E	F	G	H	I	J	K	L	M
2		6		5		4		3		2		1	
3													
4		7		8		9		10		11		12	
				15		17		16		15		14	
8				19		20		21		22		23	
9													
10				30		29		28		27		26	
11													
12				31		32		33		34		35	
13													

A. Description of original monument and accessories and/or subsequent restoration:

- M-4:** 1837 Lewis Glason Set 1/4 Sec Post  
 Wit-(1)W. Pine 18 N72W 12  
 (2)Do 8 S52 1/2W 15  
 1977 Lapham survey Fd M.S.H.D. Mon Box  
 Wit-none  
 1992-97 DNR survey, work dwg & LCRC#436  
 Fd 1 1/2" Pipe in 6" square conc block  
 Set 1"x36" galv pipe in place of fd iron  
 Wit-(3)18" Tri Oak N02W 157.34  
 (4)8" B. Cherry S65E 91.60  
 (5)16" Maple South 171.13  
 (6)4" Oak S35W 102.15
- 1997 Claypool LCRC#441 Fd DNR Mon  
 Wit-(7)N25W 17.905 m C/L Mon Box  
 (8)S40W 11.912 m 150 mm tree  
 (9)S10W 8.084 m 200 mm Poplar  
 (10)S10E 8.904 m 250 mm Poplar

B. Description of corner evidence found and/or method applied in restoring or reestablishing corner:

- M-4:** Found monument box in centerline of M-61. Found DNR 1" x 36" galvanized pipe in concrete block--agrees with DNR 1992-1997 retracement survey of most of T18N, R2E, as recorded on LCRC#436. Accepted DNR location and witness ties.

See dossier and LCRC#436 for detailed report.

C. Description of monument for corner and accessories established to perpetuate locating the position of the corner:

- M-4:** E 1/4 Corner, Section 12. Found and accepted DNR location, 1" x 36" pipe with 4" aluminum DNR cap in place of found short pipe in concrete block.


Witnesses:

- Center of monument box in center of M-61, N20 deg, 36 min W, 58.70'  
 18" Triple Oak N02W, spike & tag, 157.34'  
 8" Cherry S65E, spike & tag, 91.60'  
 16" Maple South, spike & tag, 171.13'  
 4" Oak S35W, spike & tag, 102.15'

**APPROVED LAND CORNER**  
P.A. 345 of 1990  
Gladwin County

Co. Rep. John M. Dwyer  
Date 10/14/98

Signed by Mark R. Robison  
Surveyor's Michigan License No. 27458

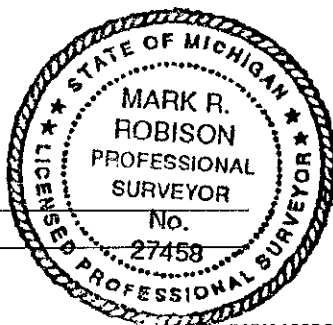

Date 10-5-98