LAND CORNER RECORDATION CERTIFICATE

Filing Requirement of Act 74, Mich. P.A. 1970

For corners in GLADWIN (County)

	Located In:			Corner Code #
1. Public Land Survey		T 18N	R 1E	L-9
		T	R	
		T	R	
		T	R	
2. Property Controlling	S 24	T	R	9, 12
in Section	S	T	R	
3. Miscellaneous	S	T	R	
Property in Section	S	T	R	

Register of Deeds Stamp & File Number

4. Lot No. _____, Recorded Plat _____
5. Private Claims _____

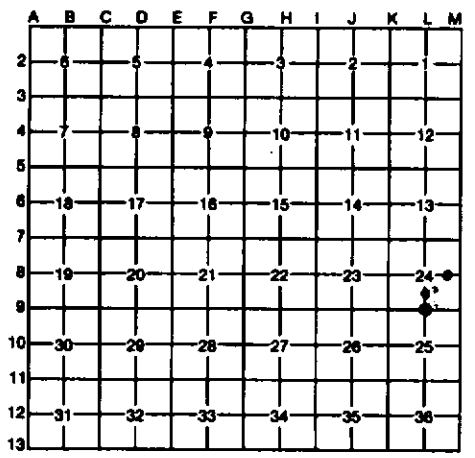

I, C.T. KIISKILA, in a field survey on JULY 20, 19 94, do hereby certify that under requirements of P.A. 74, Michigan P.A. of 1970, the corner points mentioned in lines 1 and 2 above were in conformance with regulations and rules therefore as required in the current manual of survey instructions of the United States Department of the Interior, Bureau of Land Management or by a decree of a Court of Law and/or that the corner points mentioned in lines 3, 4 and 5 above were in conformance with the rules of the Michigan Board of Professional Surveyors or by a Decree of a Court of Law; established, re-established, monumented, re-monumented, recovered, found as expressed below:

NOTE: Not more than 4 corners, all in the same town and range, may be recorded on this certificate.

A. Description of original monument and accessories and/or subsequent restoration:

L-9 9 12

(NO EVIDENCE OF G.L.O. CORNER, B.T'S, LINE TREES & TOPOGRAPHY, AS CALLED OUT IN THE G.L.O. LINE NOTES; UNLESS NOTED IN ITEM "B" BELOW.)

B. Description of corner evidence found and/or method applied in restoring or reestablishing corner:

L-9	9	12
FD CONC. MON FOR S1/4 COR OF S-24. CORNER FITS PLAT OF "WHITNEY BEACH NO. 10" BY PS, P.LAPHAM AND WAS FOUND AND RECORDED BY N.FLUHARTY IN 1978.	FD REROD W/J.SEBGNAN, PS #18664, RLS CAP FOR THE NE COR OF NW1/4 OF SE1/4 OF S-24. REROD FITS J.MEYERS 1975 CERT. OF SURVEY (MEYERS CERT. SAYS "SET 1/2" REROD") RECORDED IN LI. 001, PG. 634.	FD REROD W/J.SEBGNAN,PS #18664 CAP FOR THE SW COR OF NW1/4 OF SE1/4 S-24. COR FITS 1975 CERT. OF SURVEY BY J.MEYERS, LI. 001, PG. 636 (MEYERS CERT. SAYS "SET 1/2"x 18" REROD-RLS CAPPED). GRAVEL ROAD (NE-SW) IS 335'± NORTH.

C. Description of monument for corner and accessories established to perpetuate locating the position of the corner:

L-9			9			12		
FD 5" DIA CONC MON. ADDED LOC TAG TO FD CED POST.			FD 1/2" REROD W/RLS CAP. ADDED CED POST W/LOC TAG.			FD 1/2" REROD W/RLS CAP. ADDED CED POST W/LOC TAG.		
#15" W PINE	N15°W	30.77'						
#14" W PINE	N75°E	15.25'	1" W PINE	N30°E	46.0'	3" MAPLE	N60°E	11.49'
#86" MAPLE	S35°E	20.04'	4" ELM	S25°E	14.73'	7" MAPLE	S80°E	26.31'
#89" W PINE	S45°W	6.41'	1" MAPLE	S70°W	18.6'	17" MAPLE	S55°W	27.68'
FD 4" DIA CONC MON, NE COR OF PLAT OF "WHITNEY BEACH NO. 10"	WEST	89.10'	FD 1/2" REROD W/RLS CAP ON N'LY RD R/W. ADDED CED POST	S00°09'W	342.0'	3" W PINE	N65°W	55.34'
#8= RLS H. FLUHARTY 1978 WIT.								

STATE OF MICHIGAN
CARL KIISKILA
LAND SURVEYOR
No. 33981
LICENSED LAND SURVEYOR

Signed by Carl T. Kiiskila Date 3-28-97

Surveyor's Michigan License No. 33981

FORM APPROVED BY MICHIGAN STATE BOARD OF PROFESSIONAL SURVEYORS, JAN. 29, 1971
REVISED MAY 14, 1975
REVISED JAN., 1988